


Township 41 S Range 13 W W.M.
North

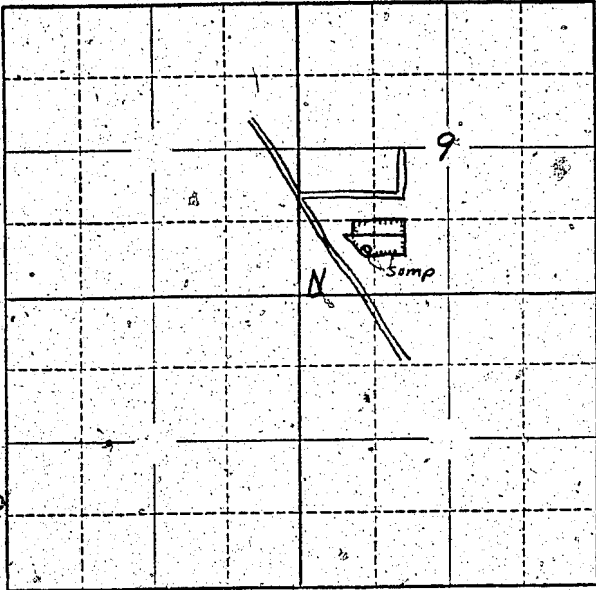

See Enclosure

Locate well and acreage of irrigated land on plat.
Scale: 2" = 1 Mile

STATE OF OREGON

County of Curry ss.

I, Joe Knutsen, being firstaduly sworn, do hereby certify that I have read the foregoing Registration Statement and that all of the items therein contained are true to the best of my knowledge and belief.

Joe Knutsen
(Signature of Registrant)

Subscribed and sworn to before me this 13th day of July, 1958

My commission expires _____

Oleta A. Walker
(Notary Public)
County Clerk Curry Co., Or.

(SEAL)

CERTIFICATE OF REGISTRATION

STATE OF OREGON
County of Marion ss.

This is to certify that the foregoing Registration Statement was received in the office of the State Engineer on the 7th day of July, 1958, at 8⁰⁰ o'clock A. M. and has been duly recorded in said office in Book No. 16 of Registration Statements on page 68-3954

Witness my hand this 15th day of February, 1960

HOWIE A. STANLEY
(State Engineer)

By _____ (Deputy)

GR. 3954

\$15.00