


North

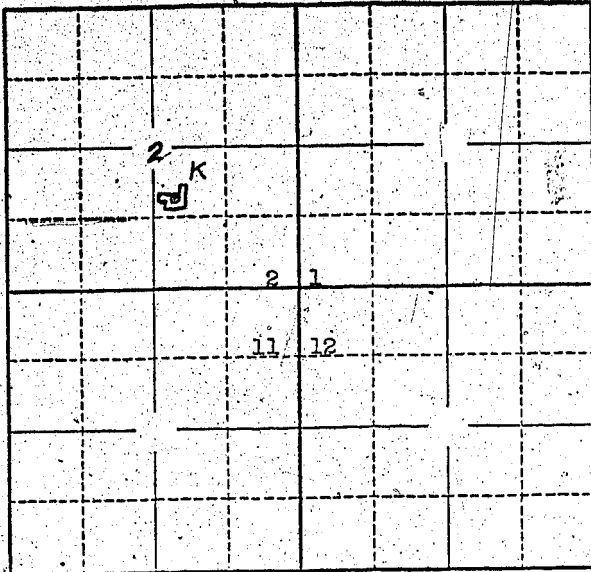

Locate well and acreage of irrigated land on plat.  
Scale: 2" = 1 Mile

STATE OF OREGON

County of Lane } ss.

William V. Chapman and  
L. Lula M. Chapman, being first duly sworn, do hereby certify that I have read the foregoing Registration Statement and that all of the items therein contained are true to the best of my knowledge and belief.

*Lula M. Chapman*  
Lula M. Chapman  
(Signature of Registrant)

Subscribed and sworn to before me this 2nd day of July, 1958.

My commission expires 2-5-61

*D. T. Bayley*  
D. T. Bayley  
(Notary Public) for Oregon

(SEAL)

CERTIFICATE OF REGISTRATION

STATE OF OREGON } ss.  
County of Marion

This is to certify that the foregoing Registration Statement was received in the office of the State Engineer on the 7th day of July, 1958, at 6:00 o'clock A.M. and has been duly recorded in said office in Book No. 9 of Registration Statements on page GR 2047.

Witness my hand this 16th day of February, 1959

*Lewis A. Stanley*  
Lewis A. Stanley  
(State Engineer)

By \_\_\_\_\_ (Deputy)

\$1500