Sec 14 Township 4S Range 3 W, W.M.

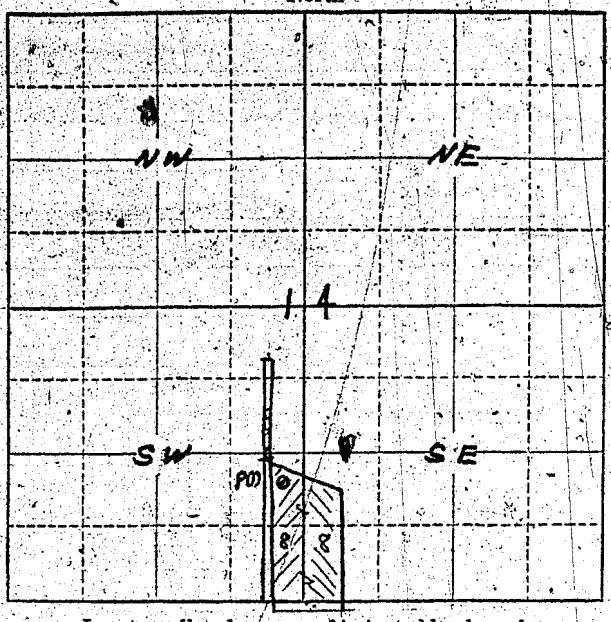

2.0 A
2 in SE 1/4 of SW 1/4
2 in SW 1/4 of SE 1/4

Locate well and acreage of irrigated land on plat.

Scale: 2" = 1 Mile

STATE OF OREGON }
County of Marion } ss.

I, [illegible], being first duly sworn, do hereby certify that I have read the foregoing Registration Statement and that all of the items therein contained are true to the best of my knowledge and belief.

[signature]
(Signature of Registrant)

Subscribed and sworn to before me this 27th day of July, 1956.

My commission expires Sept 8, 1956

[signature]
(Notary Public)

(SEAL)

CERTIFICATE OF REGISTRATION

STATE OF OREGON }
County of Marion } ss.

This is to certify that the foregoing Registration Statement was received in the office of the State Engineer on the 27th day of July, 1956, at 8 o'clock A.M. and has been duly recorded in said office in Book No. 1 of Registration Statements on page GR-199 C

~~Construction work to be completed by ... and the water to be applied to beneficial use by ...~~

Witness my hand this 23rd day of November, 1956.

Lewis A. Stanley
(State Engineer)

By .....
(Deputy)

GR-199C