


Township 11.6 Range 5 W, W.M. North

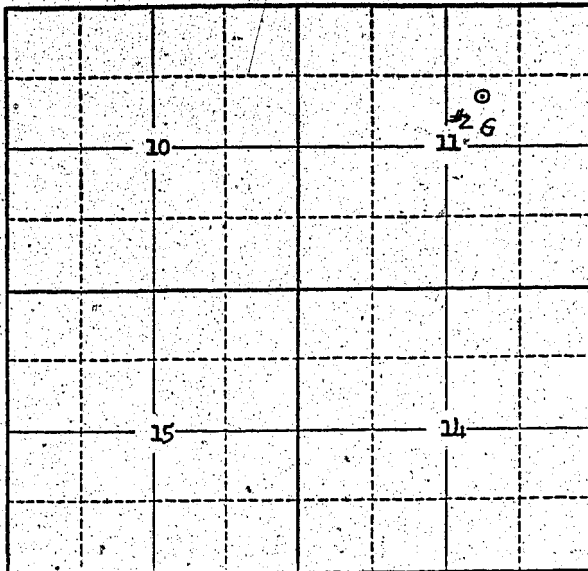

map attached to Registration Statement for Well # 1

Locate well and acreage of irrigated land on plat. Scale: 2" = 1 Mile

STATE OF OREGON }
County of Benton } ss.

I, _____, being first duly sworn, do hereby certify that I have read the foregoing Registration Statement and that all of the items therein contained are true to the best of my knowledge and belief.

[Signature]
(Signature of Registrant)

Subscribed and sworn to before me this 12th day of July, 1958

My commission expires Feb. 14, 1961 *[Signature]*
(Notary Public)

(SEAL)

CERTIFICATE OF REGISTRATION

STATE OF OREGON }
County of Marion } ss.

This is to certify that the foregoing Registration Statement was received in the office of the State Engineer on the 15th day of July, 1958, at 8:00 o'clock A.M. and has been duly recorded in said office in Book No. 9 of Registration Statements on page GR-2058

Witness my hand this 16th day of February, 1959

[Signature]
(State Engineer)

By _____
(Deputy)

\$1500