Township 9 S., Range 3 W., W.M.

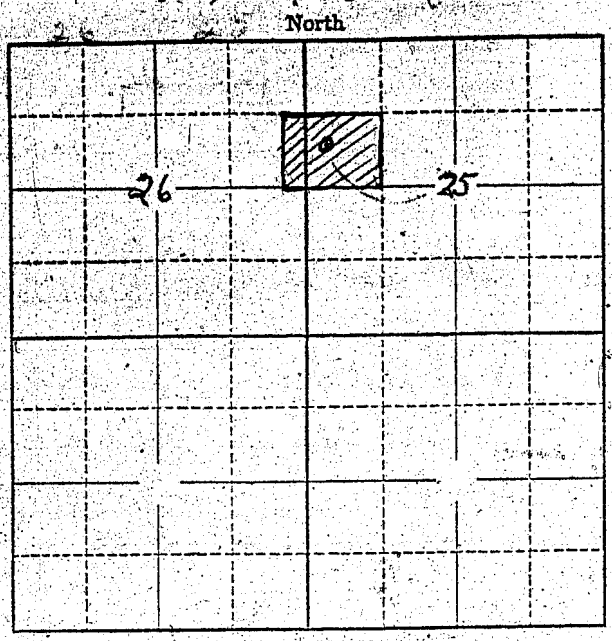

Locate well and acreage of irrigated land on plat.

Scale: 2" = 1 Mile

STATE OF OREGON
County of Marion } ss.

I, Mary F. Petzel, being first duly sworn, do hereby certify that I have read the foregoing Registration Statement and that all of the items therein contained are true to the best of my knowledge and belief.

x Mary F. Petzel
(Signature of Registrant)

Subscribed and sworn to before me this 31st day of July, 1956

My commission expires Feb. 18, 1959 Mildred E. Lane
(Notary Public) Oregon

(SEAL)

CERTIFICATE OF REGISTRATION

STATE OF OREGON
County of Marion } ss.

This is to certify that the foregoing Registration Statement was received in the office of the State Engineer on the 31st day of July, 1956, at 10 o'clock A. M. and has been duly recorded in said office in Book No. 2 of Registration Statements on page GR-200 C.

~~Construction was completed by x-x-x-x-x-x-x-x-x-x-19xx and the water was applied to beneficial use by x-x-x-x-x-x-x-x-x-x-19xx.~~

Witness my hand this 23rd day of November, 1956

Lewis A. Stanley
(State Engineer)

By ..... (Deputy)

GR-200 C