


Township 155 Range 4W W.M.
North

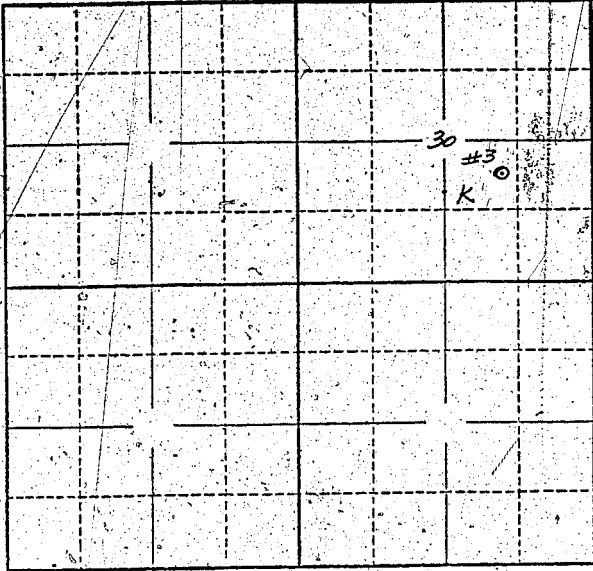

Locate well and acreage of irrigated land on plat.
Scale: 2" = 1 Mile

STATE OF OREGON

County of Grant } ss.

I, Henry D. Paschke, being first duly sworn, do hereby certify that I have read the foregoing Registration Statement and that all of the items therein contained are true to the best of my knowledge and belief.

Henry D. Paschke
(Signature of Registrant)

Subscribed and sworn to before me this 14th day of August, 1958.

My commission expires Aug 3, 1958
Henry S. M. [unclear]
(Notary Public)

(SEAL)

CERTIFICATE OF REGISTRATION

STATE OF OREGON

County of Marion } ss.

This is to certify that the foregoing Registration Statement was received in the office of the State Engineer on the 15th day of July, 1958, at 8.00 o'clock A. M. and has been duly recorded in said office in Book No. 9 of Registration Statements on page GR-2066

Witness my hand this 16th day of February, 1959

1950

Lewis A. Stanley
(State Engineer)

By _____ (Deputy)

GR - 2066