


Township 15S Range 4W W.M.
North

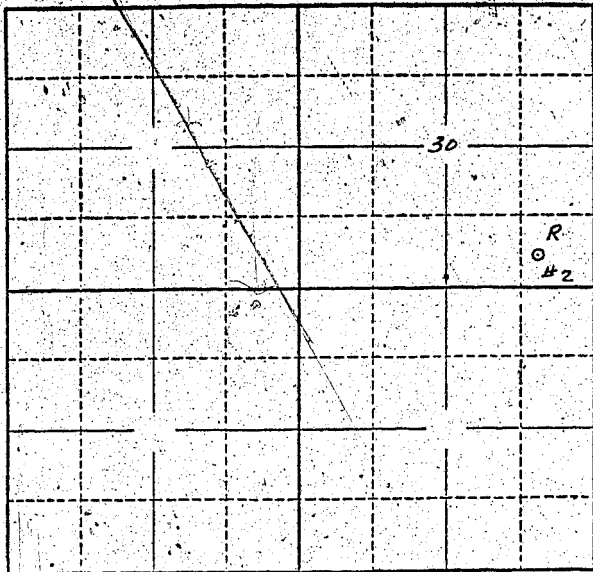

Locate well and acreage of irrigated land on plat,
Scale: 2" = 1 Mile

STATE OF OREGON

County of Lane } ss.

I, Henry O. Paschke, being first duly sworn, do hereby certify that I have read the foregoing Registration Statement and that all of the items therein contained are true to the best of my knowledge and belief.

Henry O. Paschke
(Signature of Registrant)

Subscribed and sworn to before me this 14th day of July, 1958

My commission expires Aug 3, 1958
Harry E. Smith
(Notary Public)

(SEAL)

CERTIFICATE OF REGISTRATION

STATE OF OREGON

County of Marion } ss.

This is to certify that the foregoing Registration Statement was received in the office of the State Engineer on the 15th day of July, 1958, at 8.00 o'clock A. M. and has been duly recorded in said office in Book No. 9 of Registration Statements on page OR 2067

Witness my hand this 16th day of February, 1959

Lewis A. Stanley
(State Engineer)

By _____ (Deputy)

GR - 2067

1500