


Range 2 W.

Township 7 S Range 2 W, W.M.
North

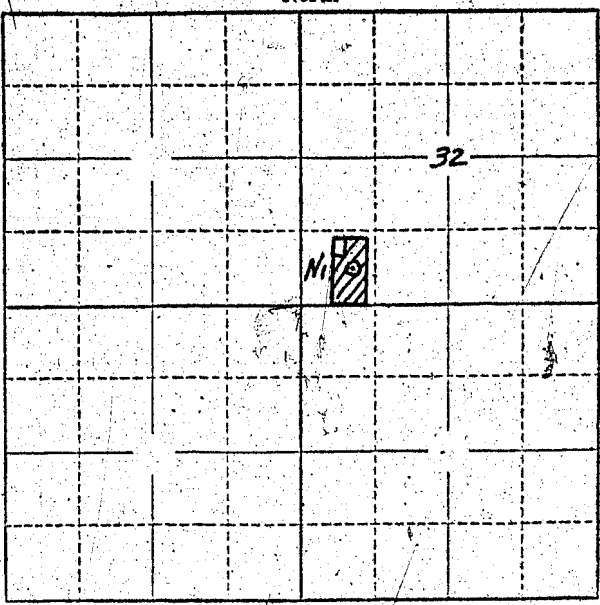

Locate well and acreage of irrigated land on plat.
Scale: 2" = 1 Mile

STATE OF OREGON

County of Marion } ss.

I, Jerimina Cherry, being first duly sworn, do hereby certify that I have read the foregoing Registration Statement and that all of the items therein contained are true to the best of my knowledge and belief.

Jerimina Cherry
(Signature of Registrant)

Subscribed and sworn to before me this 28 day of July, 1956

My commission expires March 4, 1958 Allen R. Gordon
(Notary Public)

(SEAL)

CERTIFICATE OF REGISTRATION

STATE OF OREGON

County of Marion } ss.

This is to certify that the foregoing Registration Statement was received in the office of the State Engineer on the 1st day of August, 1956, at 10 o'clock A. M. and has been duly recorded in said office in Book No. 2 of Registration Statements on page GR-201 C

~~Construction shall be completed by x-x-x-x-x-x-x-x-x-x-19-x-x and the water completely applied to benefit x-x-x-x-x-x-x-x-x-x-19-x-x~~

Witness my hand this 23rd day of November, 1956

Levin A. Stanley
(State Engineer)

By _____
(Deputy)