


Township 26.5 Range 6W, W.M.

North

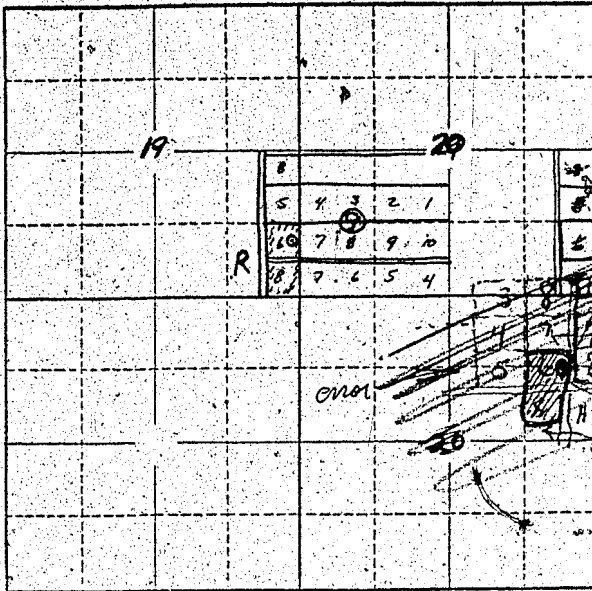

Locate well and acreage of irrigated land on plat.

Scale: 2" = 1 Mile

Block 9
1000
Well
Block 10
Well in lot #6
of Block 9
Irrigate in lot 6
and lot 3-Block 10

STATE OF OREGON

County of Douglas } ss.

I, Carl W. Schmidt, being first duly sworn, do hereby certify that I have read the foregoing Registration Statement and that all of the items therein contained are true to the best of my knowledge and belief.

Carl W. Schmidt
(Signature of Registrant)

Subscribed and sworn to before me this 18 day of June, 1958

My commission expires Oct. 25, 1959
(Notary Public)

(SEAL)

CERTIFICATE OF REGISTRATION

STATE OF OREGON

County of Marion } ss.

This is to certify that the foregoing Registration Statement was received in the office of the State Engineer on the 15th day of July, 1958, at 2:00 o'clock A.M. and has been duly recorded in said office in Book No. 16 of Registration Statements on page GR-3938

Witness my hand this 15th day of February, 1960

W. A. Stanley
(State Engineer)

By (Deputy)