


Township 12S Range 4W, W.M.
North

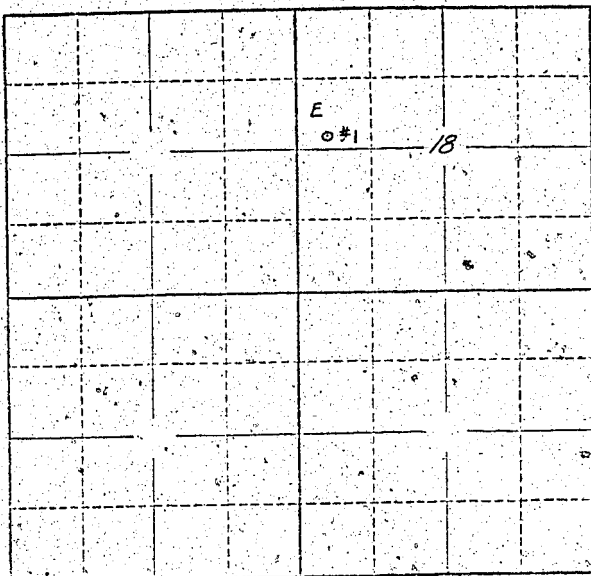

~~See map~~
~~to application~~

Locate well and acreage of irrigated land on plat.
Scale: 2" = 1 Mile

STATE OF OREGON

County of Marion

ss.

I, Therell F. Neville, being first duly sworn, do hereby certify that I have read the foregoing Registration Statement and that all of the items therein contained are true to the best of my knowledge and belief.

Therell F. Neville
(Signature of Registrant)

Subscribed and sworn to before me this 15th day of July, 1958

My commission expires 12th June 1961

Wm. S. Bartholomew
(Notary Public)

(SEAL)

CERTIFICATE OF REGISTRATION

STATE OF OREGON

County of Marion

ss.

This is to certify that the foregoing Registration Statement was received in the office of the State Engineer on the 15th day of July, 1958, at 8:30 o'clock A. M. and has been duly recorded in said office in Book No. 9 of Registration Statements on page GR-2085

~~Construction shall be completed by _____ and the water complete applied to _____~~
~~_____~~

Witness my hand this 16th day of February, 1959

Lawrence A. Ostrander
(State Engineer)

By _____ (Deputy)