


Township 14S Range 5W W.M.
North

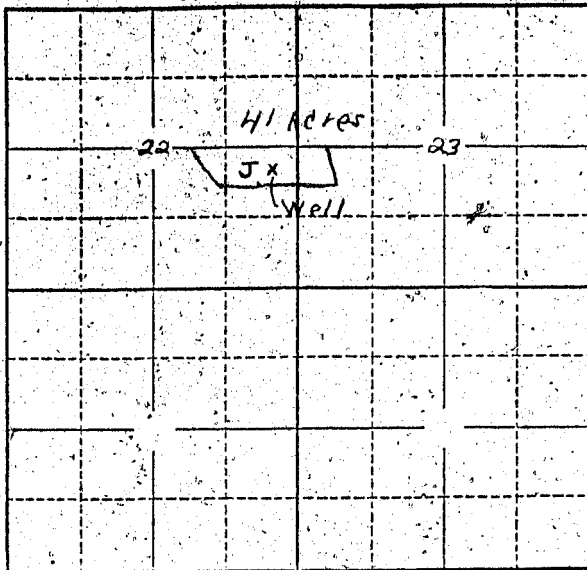

Locate well and acreage of irrigated land on plat.

Scale: 2" = 1 Mile

STATE OF OREGON

County of Benton

} ss.

I, Clarence Becker, being first duly sworn, do hereby certify that I have read the foregoing Registration Statement and that all of the items therein contained are true to the best of my knowledge and belief.

x Clarence Becker
(Signature of Registrant)

Subscribed and sworn to before me this 9th day of March, 1959

My commission expires Dec 11, 1959

H. Turner
(Notary Public)

(SEAL)

CERTIFICATE OF REGISTRATION

STATE OF OREGON

County of Marion

} ss.

This is to certify that the foregoing Registration Statement was received in the office of the State Engineer on the 16th day of July, 1958, at 8:00 o'clock A.M. and has been duly recorded in said office in Book No. 11 of Registration Statements on page GR-2421

Witness my hand this 16th day of March, 1959

Laura A. Ottom
(State Engineer)

By _____ (Deputy)

GR-2421

\$16.65