

Locate well and acreage of irrigated land on plat.
Scale: 2" = 1 Mile

STATE OF OREGON

County of _____ } ss.

I, _____, being first duly sworn, do hereby certify that I have read the foregoing Registration Statement and that all of the items therein contained are true to the best of my knowledge and belief.

(Signature of Registrant)

Subscribed and sworn to before me this _____ day of _____, 19____

My commission expires _____ (Notary Public)

(SEAL)

FOR CERTIFICATE SEE PAGE GR-204 G
CERTIFICATE OF REGISTRATION


STATE OF OREGON } ss.
County of Marion

This is to certify that the foregoing Registration Statement was received in the office of the State Engineer of the _____ day of _____, 19____, and has been duly recorded in said office in Book No. _____ of Registration Statements on page _____ Construction shall be completed by _____ and the water completely applied to beneficial use by _____.

Witness my hand this _____ day of _____, 19____

(State Engineer)

By _____ (Deputy)

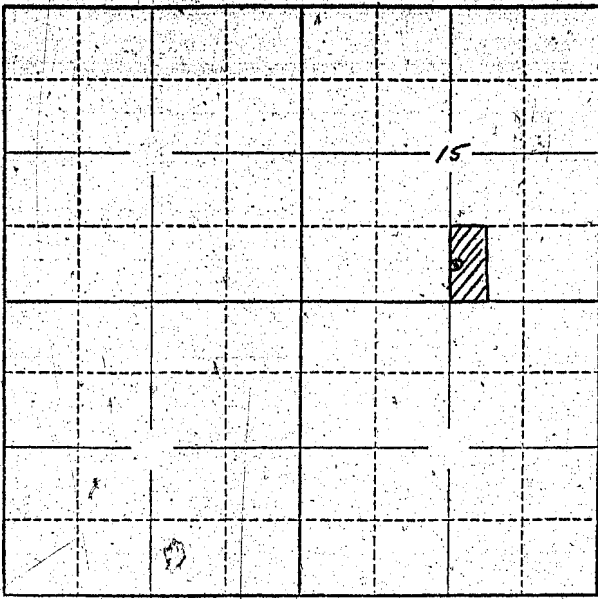

Locate well and acreage of irrigated land on plat.
Scale: 2" = 1 Mile

STATE OF OREGON

County of Marion } ss.

I, Carl Bethel, being first duly sworn, do hereby certify that I have read the foregoing Registration Statement and that all of the items therein contained are true to the best of my knowledge and belief.

Carl Bethel
(Signature of Registrant)

Subscribed and sworn to before me this 2nd day of August, 1956.

My commission expires Sept. 8, 1956 Chris L. ...
(Notary Public)

(SEAL)

CERTIFICATE OF REGISTRATION

STATE OF OREGON

County of Marion } ss.

This is to certify that the foregoing Registration Statement was received in the office of the State Engineer on the 2nd day of August, 1956, at 12 o'clock A. M. and has been duly recorded in said office in Book No. 2 of Registration Statements on page GR-204 G.

~~Construction shall be completed by ... and the water completely applied to ...~~

Witness my hand this 23rd day of November, 1956.

Stuart A. Stanley
(State Engineer)

By _____
(Deputy)