Township 6 S Range 3W W.M.

North

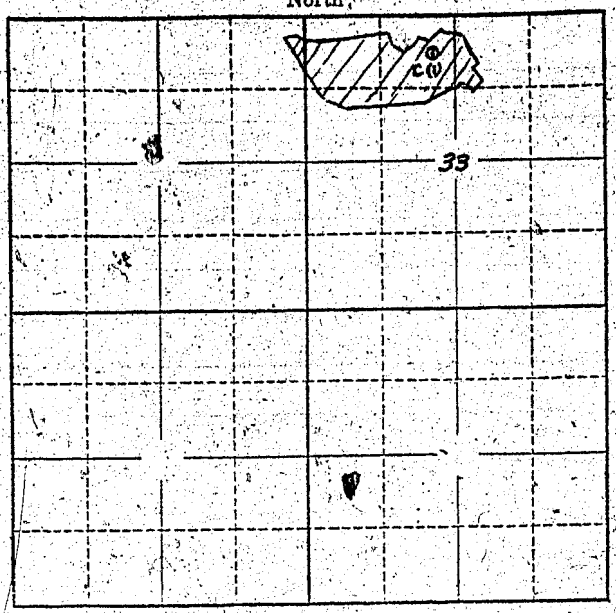

Map accompanies statement

Locate well and acreage of irrigated land on plat.

Scale: 2" = 1 Mile

STATE OF OREGON

County of Marion

I, Wm Wiederkehr, being first duly sworn, do hereby certify that I have read the foregoing Registration Statement and that all of the items therein contained are true to the best of my knowledge and belief.

Wm Wiederkehr
(Signature of Registrant)

Subscribed and sworn to before me this 3rd day of August, 19 56.

My commission expires 9/27/58

Jeanie Baxter
(Notary Public)

(SEAL)

CERTIFICATE OF REGISTRATION

STATE OF OREGON }
County of Marion } ss.

This is to certify that the foregoing Registration Statement was received in the office of the State Engineer on the 3rd day of August, 19 56, at 10:00 o'clock A. M. and has been duly recorded in said office in Book No. 2 of Registration Statements on page GR-205 C

~~Construction of wells completed by X-X-X-X-X-X-X-X-X-X-X-X-X-X-X and the water completely applied to beneficial use by X-X-X-X-X-X-X-X-X-X-X-X-X-X-~~

Witness my hand this 23rd day of November, 19 56

Lewis A. Stanley
(State Engineer)

By
(Deputy)

GR-205 C