


Township 11S Range 5W W.M.

North

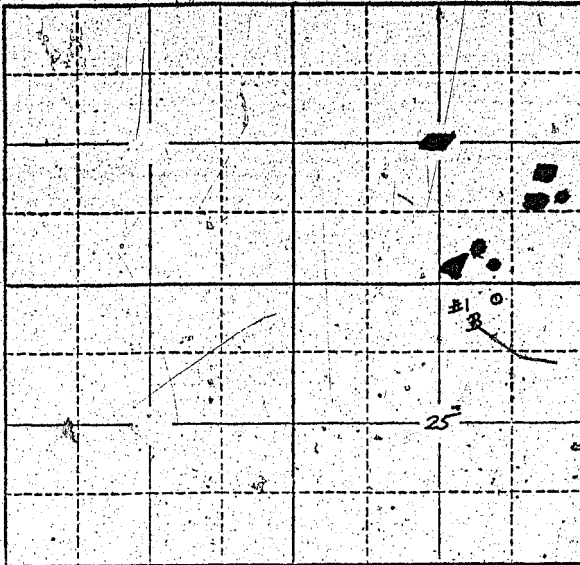

Locate well and acreage of irrigated land on plat.

Scale: 2" = 1 Mile

STATE OF OREGON

County of Benton

} ss.

I, Herрман J. Hissler, being first duly sworn, do hereby certify that I have read the foregoing Registration Statement and that all of the items therein contained are true to the best of my knowledge and belief.

Herрман J. Hissler
(Signature of Registrant)

Subscribed and sworn to before me this 11th day of July, 1958

My commission expires Sept. 29, 1961

Margaret B. Johnson
(Notary Public)

(SEAL)

CERTIFICATE OF REGISTRATION

STATE OF OREGON

County of Marion

} ss.

This is to certify that the foregoing Registration Statement was received in the office of the State Engineer on the 15th day of July, 1958, at 8:00 o'clock A.M. and has been duly recorded in said office in Book No. 9 of Registration Statements on page GR-2127

~~Construction shall be completed by _____ 19____ and the certificate of completion applied for beneficial use _____ 19____~~

Witness my hand this 10th day of March

1959

Anna A. Stanley
(State Engineer)

By _____

(Deputy)

GR-2127

1500