


GALIN-FLORY FARMS
8653 S. LONE ELDER
CANBY OR
97013

SECTION 9

T 4 S R 1 E

TAX LOT NO 3500

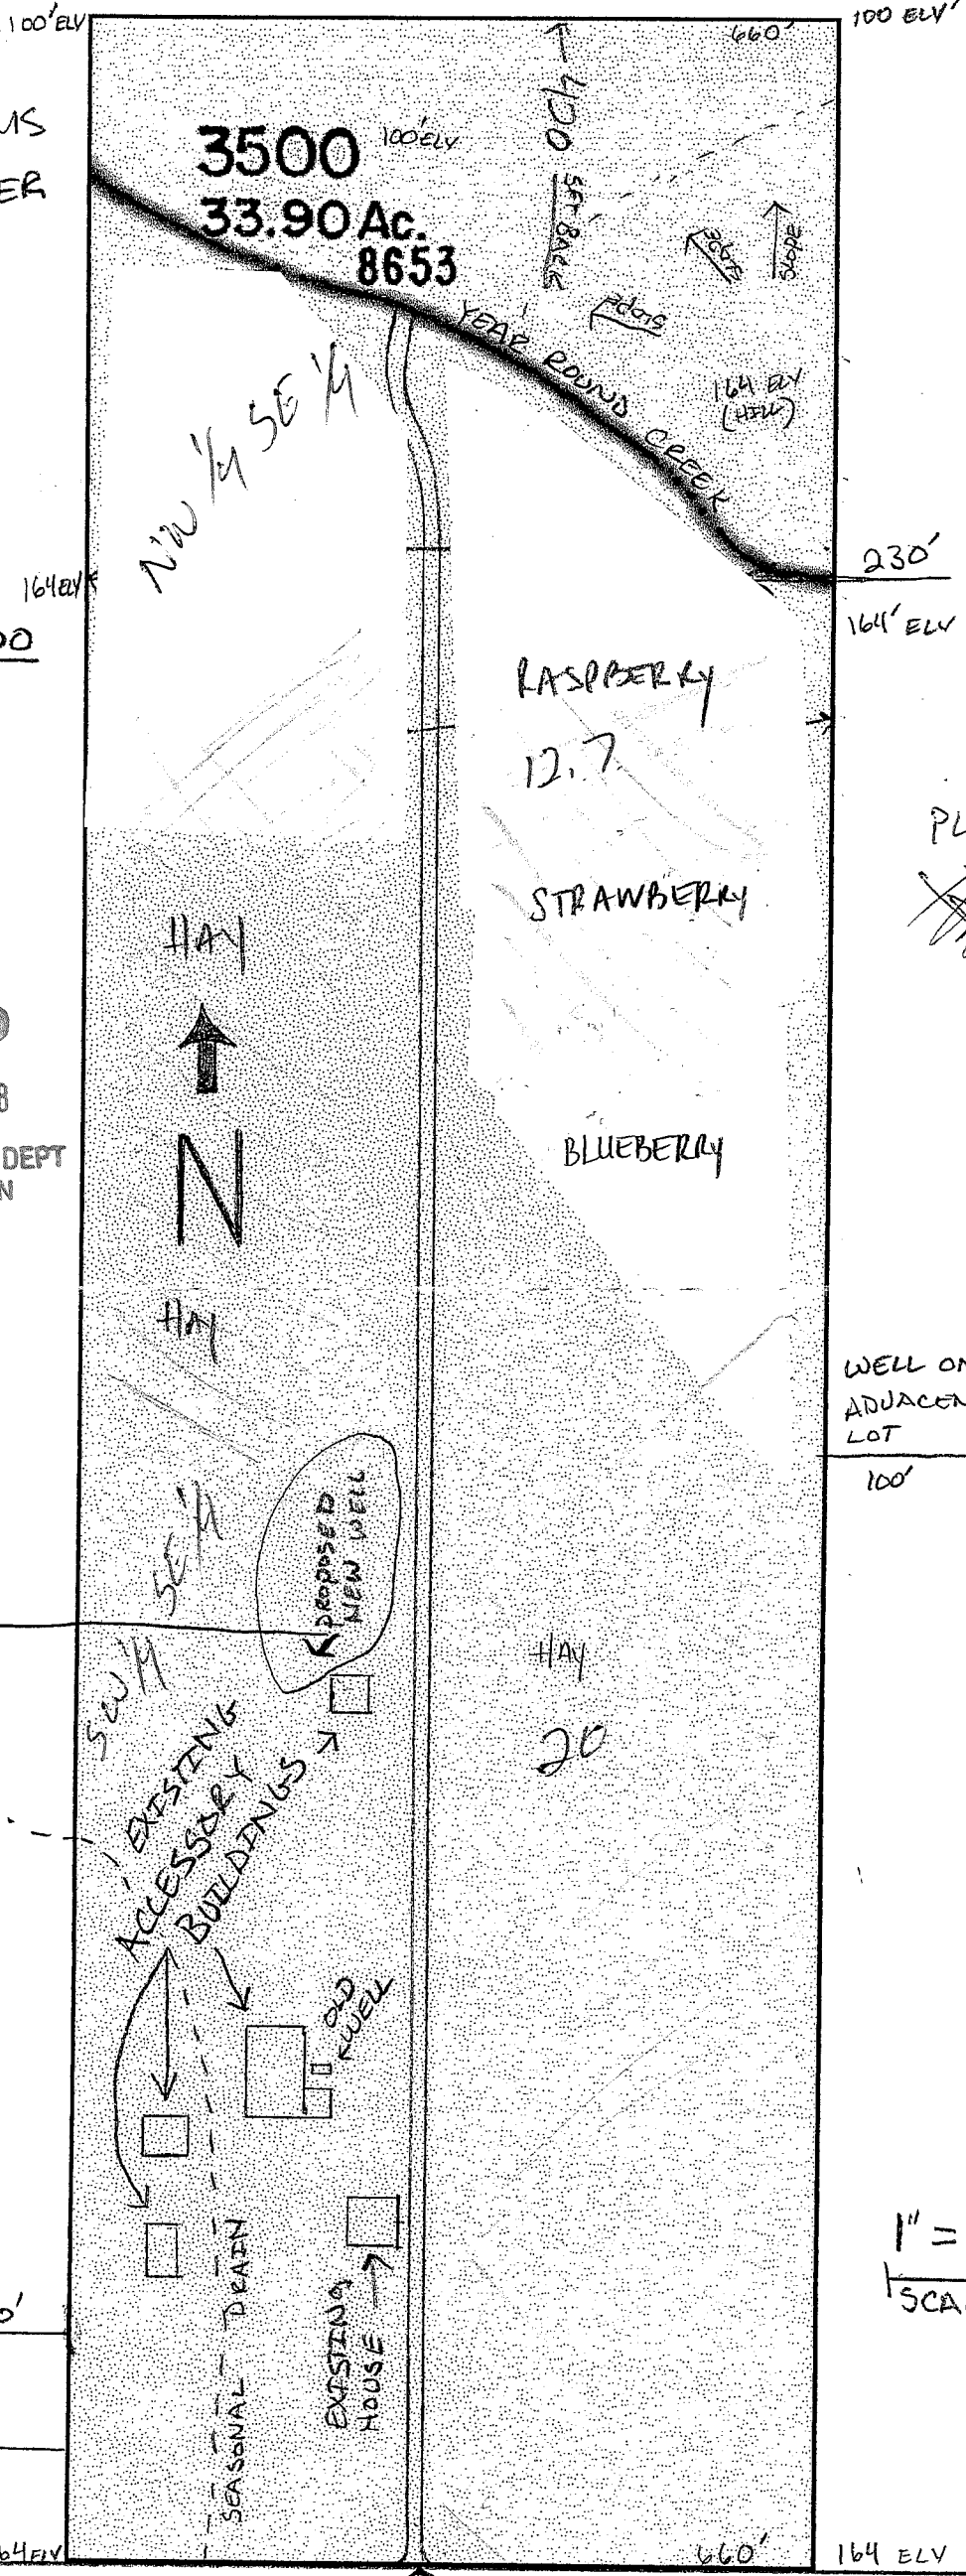

230' SETBACK
164' ELV

PLACE OF
~~USE~~

WELL ON
ADJACENT
LOT
100'

1" = 160'
SCALE

RECEIVED
MAR 24 2008
WATER RESOURCES DEPT
SALEM, OREGON

WELL
LOCATION

N 45° 13.954
W 122° 41.322

WELLS ON
ADJACENT
LOT
100'

330'

LONE ELDER RD

DRIVEWAY

S LONE ELDER ROAD