


Township 13S Range 4E W.M.
North

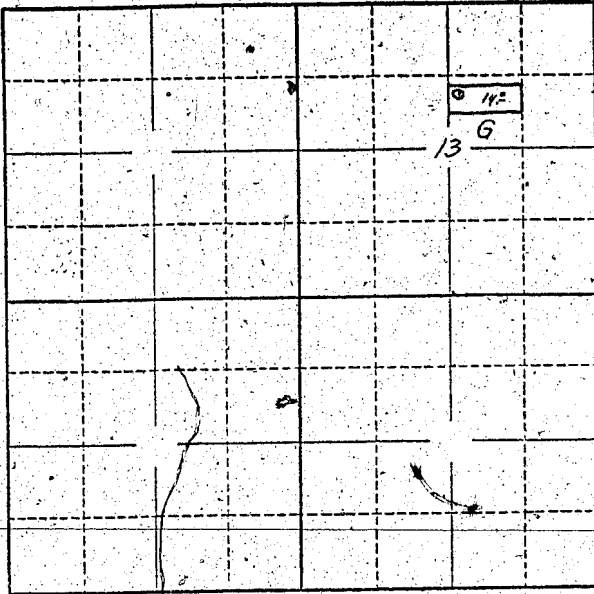

See 32461

Locate well and acreage of irrigated land on plat.
Scale: 2" = 1 Mile

STATE OF OREGON

County of Benton } ss.

I, Neil S. Vandenberg, being first duly sworn, do hereby certify that I have read the foregoing Registration Statement and that all of the items therein contained are true to the best of my knowledge and belief.

Neil S. Vandenberg
(Signature of Registrant)

Subscribed and sworn to before me this 16th day of July, 1958

My commission expires Dec. 11, 1959

H. L. ...
Notary Public for the State of Oregon
My Commission Expires Dec. 11, 1958

(SEAL)

CERTIFICATE OF REGISTRATION

STATE OF OREGON

County of Marion } ss.

This is to certify that the foregoing Registration Statement was received in the office of the State Engineer on the 17th day of July, 1958, at 8.00 o'clock A.M. and has been duly recorded in said office in Book No. 16 of Registration Statements on page GR-3863

Witness my hand this 28th day of December, 1959

Laura A. Stanley
(State Engineer)

By _____ (Deputy)

\$15.00