


Township 6S Range 3W, W.M.
North

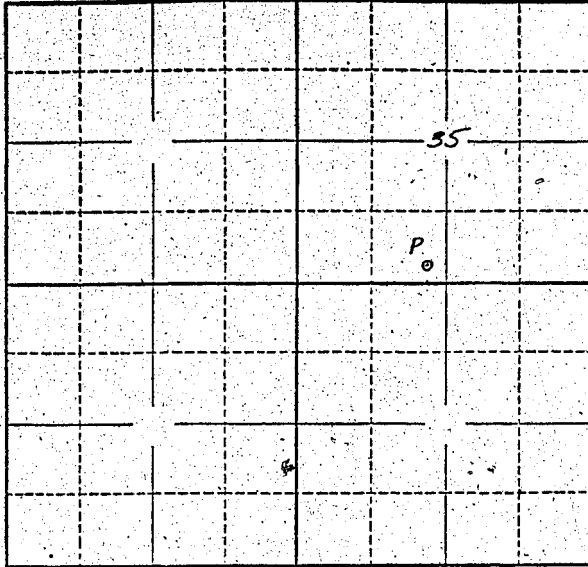

Locate well and acreage of irrigated land on plat.

Scale: 2" = 1 Mile

STATE OF OREGON

County of Marion } ss.

I, [Signature], being first duly sworn, do hereby certify that I have read the foregoing Registration Statement and that all of the items therein contained are true to the best of my knowledge and belief.

[Signature]
(Signature of Registrant)

Subscribed and sworn to before me this 16 day of July, 1958.

My commission expires Dec 5th 1959 William T. [Signature]
(Notary Public)

(SEAL)

CERTIFICATE OF REGISTRATION

STATE OF OREGON }
County of Marion } ss.

This is to certify that the foregoing Registration Statement was received in the office of the State Engineer on the 18th day of July, 1958, at 3:30 o'clock P.M. and has been duly recorded in said office in Book No. 10 of Registration Statements on page GR-2173

Witness my hand this 10th day of March, 1959.

[Signature]
(State Engineer)

By _____
(Deputy)

GR-2173

8/5-52