

Locate well and acreage of irrigated land, on plat.
 Scale: 2" = 1 Mile

STATE OF OREGON

County of Multnomah } ss.

I, Leo C. Bernardini, being first duly sworn, do hereby certify that I have read the foregoing Registration Statement and that all of the items therein contained are true to the best of my knowledge and belief.

Leo C. Bernardini
 (Signature of Registrant)

Subscribed and sworn to before me this 7th day of August, 1956.

My commission expires Sept. 8, 1956 (Notary Public)

(SEAL)

See Page GR-210 G for Certificate
CERTIFICATE OF REGISTRATION

STATE OF OREGON

County of Marion } ss.


~~This is to certify that the foregoing Registration Statement was received in the office of the State Engineer on the X-X-X day of X-X-X-X-X-X-X-X, 19X-X, at X-X-X-X-X-X-X-X, and has been duly recorded in said office in Book No. X-X-X-X-X of Registration Statements on page X-X-X-X-X.~~

~~Construction thereof completed by X-X-X-X-X-X-X-X, 19X-X, and the water completely applied to beneficial use by X-X-X-X-X-X-X-X, 19X-X.~~

Witness my hand this day of, 19.....

(State Engineer)

By (Deputy)

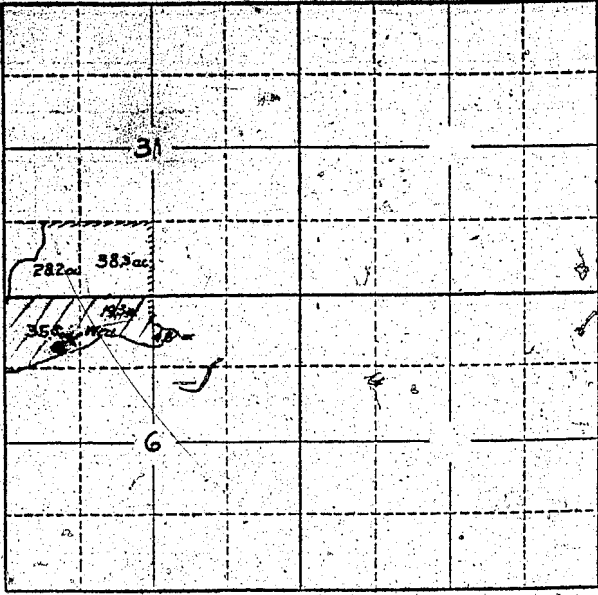

Locate well and acreage of irrigated land on plat.
Scale: 2" = 1 Mile

STATE OF OREGON
County of Multnomah } ss.

I, Leo C. Bernardini, being first duly sworn, do hereby certify that I have read the foregoing Registration Statement and that all of the items therein contained are true to the best of my knowledge and belief.

Wm. Calvary Lemistry
By Leo C. Bernardini, Sup
(Signature of Registrant)

Subscribed and sworn to before me this 7th day of August, 1956

My commission expires Sept 8, 1956 (Notary Public)

(SEAL)

CERTIFICATE OF REGISTRATION

STATE OF OREGON } ss.
County of Marion

This is to certify that the foregoing Registration Statement was received in the office of the State Engineer on the 7th day of August, 1956, at 10:30 o'clock A. M. and has been duly recorded in said office in Book No. 2 of Registration Statements on page GR-210 G

~~Construction shall be completed by X-X-X-X-X-X-X-X-X-X-X-X-X-X and the water completely applied to
benefit use by X-X-X-X-X-X-X-X-X-X-X-X-X-X~~

Witness my hand this 23rd day of November, 1956
Laura A. Stanley
(State Engineer)

By _____ (Deputy)