Township 4 S Range 3 W, W.M.

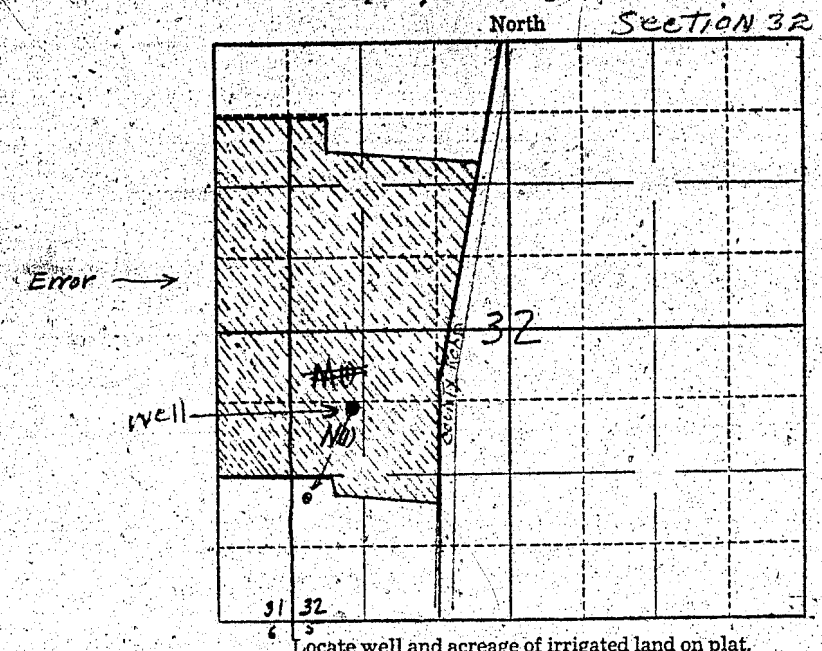

Locate well and acreage of irrigated land on plat.

Scale: ~~2" = 1 Mile~~ 1" = 400'

STATE OF OREGON }
County of Yamhill } ss.

I, Richard M Lytton, being first duly sworn, do hereby certify that I have read the foregoing Registration Statement and that all of the items therein contained are true to the best of my knowledge and belief.

Richard M Lytton
(Signature of Registrant)

Subscribed and sworn to before me this 30th day of July, 1957.

My commission expires Feb 1 1957

Hawkins
(Notary Public)

(SEAL)

CERTIFICATE OF REGISTRATION

STATE OF OREGON }
County of Marion } ss.

This is to certify that the foregoing Registration Statement was received in the office of the State Engineer on the 7th day of August, 19 57, at 10:30 o'clock A.M. and has been duly recorded in said office in Book No. 2 of Registration Statements on page GR-315.C

~~Construction shall be completed by X-X-X-X-X-X-X-X-19-X-X, and the water completely applied to beneficial use by X-X-X-X-X-X-X-X-X-19-X-X-X~~

Witness my hand this 1st day of April, 19 57

Lewis A Stanley
(State Engineer)

#16.50

By
(Deputy)

GR-315C