


Township 37s Range 2w W.M.
North

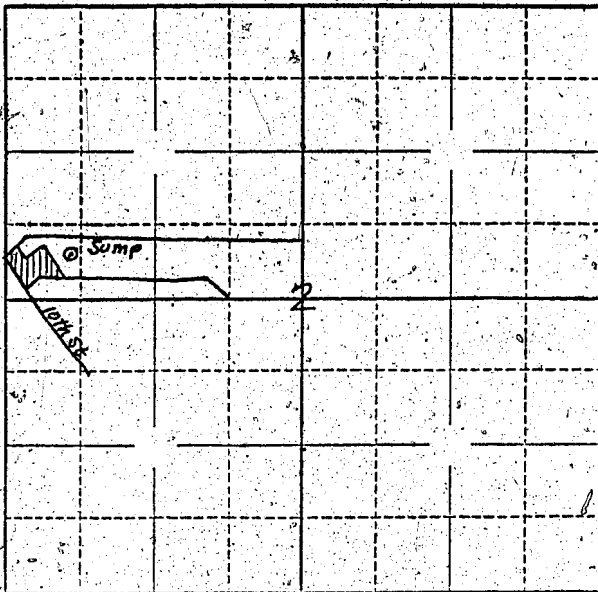

Locate well and acreage of irrigated land on plat.

Scale: $\frac{2''}{4''} = 1 \text{ Mile}$

STATE OF OREGON

County of Jackson } ss.

I, Willard Ball, being first duly sworn, do hereby certify that I have read the foregoing Registration Statement and that all of the items therein contained are true to the best of my knowledge and belief.

Willard Ball
(Signature of Registrant)

Subscribed and sworn to before me this 22 day of Sept, 1955

My commission expires _____

Marion J. Japic
(Notary Public)

(SEAL)

MY COMMISSION EXPIRES JULY, 29, 195

CERTIFICATE OF REGISTRATION

STATE OF OREGON

County of Marion } ss.

This is to certify that the foregoing Registration Statement was received in the office of the State Engineer on the 4th day of October, 1955, at 1:00 o'clock P. M. and has been duly recorded in said office in Book No. 1 of Registration Statements on page 19.

Construction shall be completed by 15 _____, 1955, and the water 15 completely applied to beneficial use by _____, 1955.

Witness my hand this 24th day of February, 1956.

Lewis A. Stanley
(State Engineer)

By _____
(Deputy)