


Township 4S Range 4W, W.M.  
North

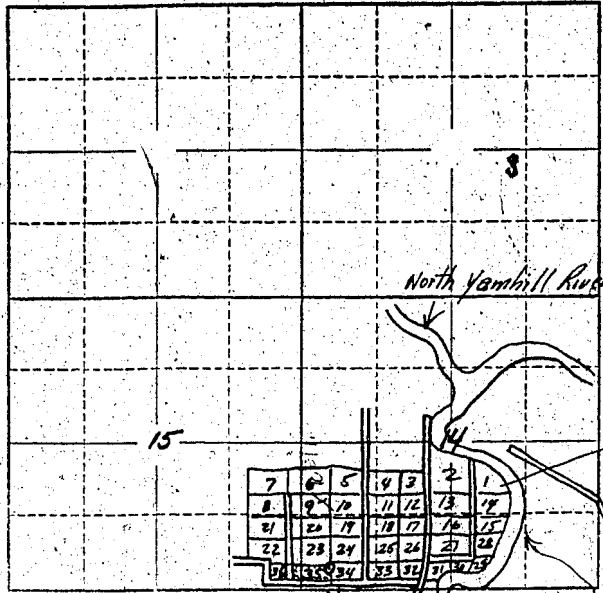

Lots of Riverside Orchards  
SE 1/4 of SE 1/4 Sec 15 1 Ac  
SW 1/4 of SW 1/4 Sec 14 2 Ac  
Being in Lots 34 and 35 of Riverside Orchards.

Locate well and acreage of irrigated land on plat.  
Scale: 2" = 1 Mile

STATE OF OREGON

County of Yamhill } ss.

I, Robert F. Koester, being first duly sworn, do hereby certify that I have read the foregoing Registration Statement and that all of the items therein contained are true to the best of my knowledge and belief.

Robert F. Koester  
(Signature of Registrant)

Subscribed and sworn to before me this 17 day of July, 1958.

My commission expires Jan. 26, 1959  
Rebecca E. Vernon  
(Notary Public)

(SEAL)

**CERTIFICATE OF REGISTRATION**

STATE OF OREGON }  
County of Marion } ss.

This is to certify that the foregoing Registration Statement was received in the office of the State Engineer on the 18th day of July, 1958, at 8:00 o'clock A. M. and has been duly recorded in said office in Book No. 16 of Registration Statements on page GR 4007

~~Construction shall be completed by \_\_\_\_\_ and the water completely applied to beneficial use by \_\_\_\_\_~~

Witness my hand this 15th day of March, 1960.

[Signature]  
(State Engineer)

By \_\_\_\_\_ (Deputy)

GR-4007

#15.00