


North

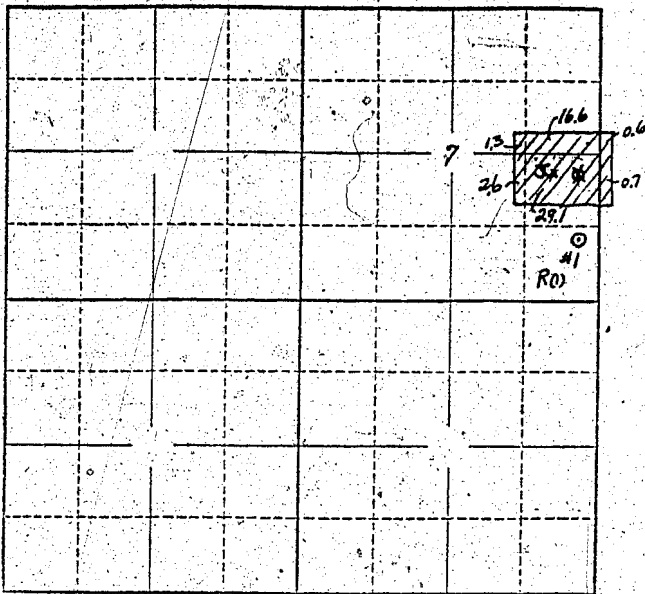

Locate well and acreage of irrigated land on plat.

Scale: 2" = 1 Mile

STATE OF OREGON

County of Lane

ss.

I, L.J. & J.L. Getchell

being first duly sworn, do hereby certify that I have read the foregoing Registration Statement and that all of the items therein contained are true to the best of my knowledge and belief.

L.J. & J.L. Getchell

(Signature of Registrant)

Subscribed and sworn to before me this _____ day of _____, 19____

My commission expires _____

(Notary Public)

(SEAL)

SEE PAGE GR-229 G FOR CERTIFICATE OF REGISTRATION

STATE OF OREGON

County of Marion

ss.

This is to certify that the foregoing Registration Statement was received in the office of the State Engineer on the _____ day of _____, 19____, and has been duly recorded in said office in Book No. _____ of Registration Statements on page _____.

Confirmation should be completed by _____, 19____, and the return completely applied to _____.

Witness my hand this _____ day of _____, 19____

(State Engineer)

By _____

(Deputy)

