


MRS. W. H. FAULKNER
 121, Box 308,
 ALBANY, ORISUGAI
 S. 15 + 16 T. 11 S., R. 2 W.

STATE ENGINEER

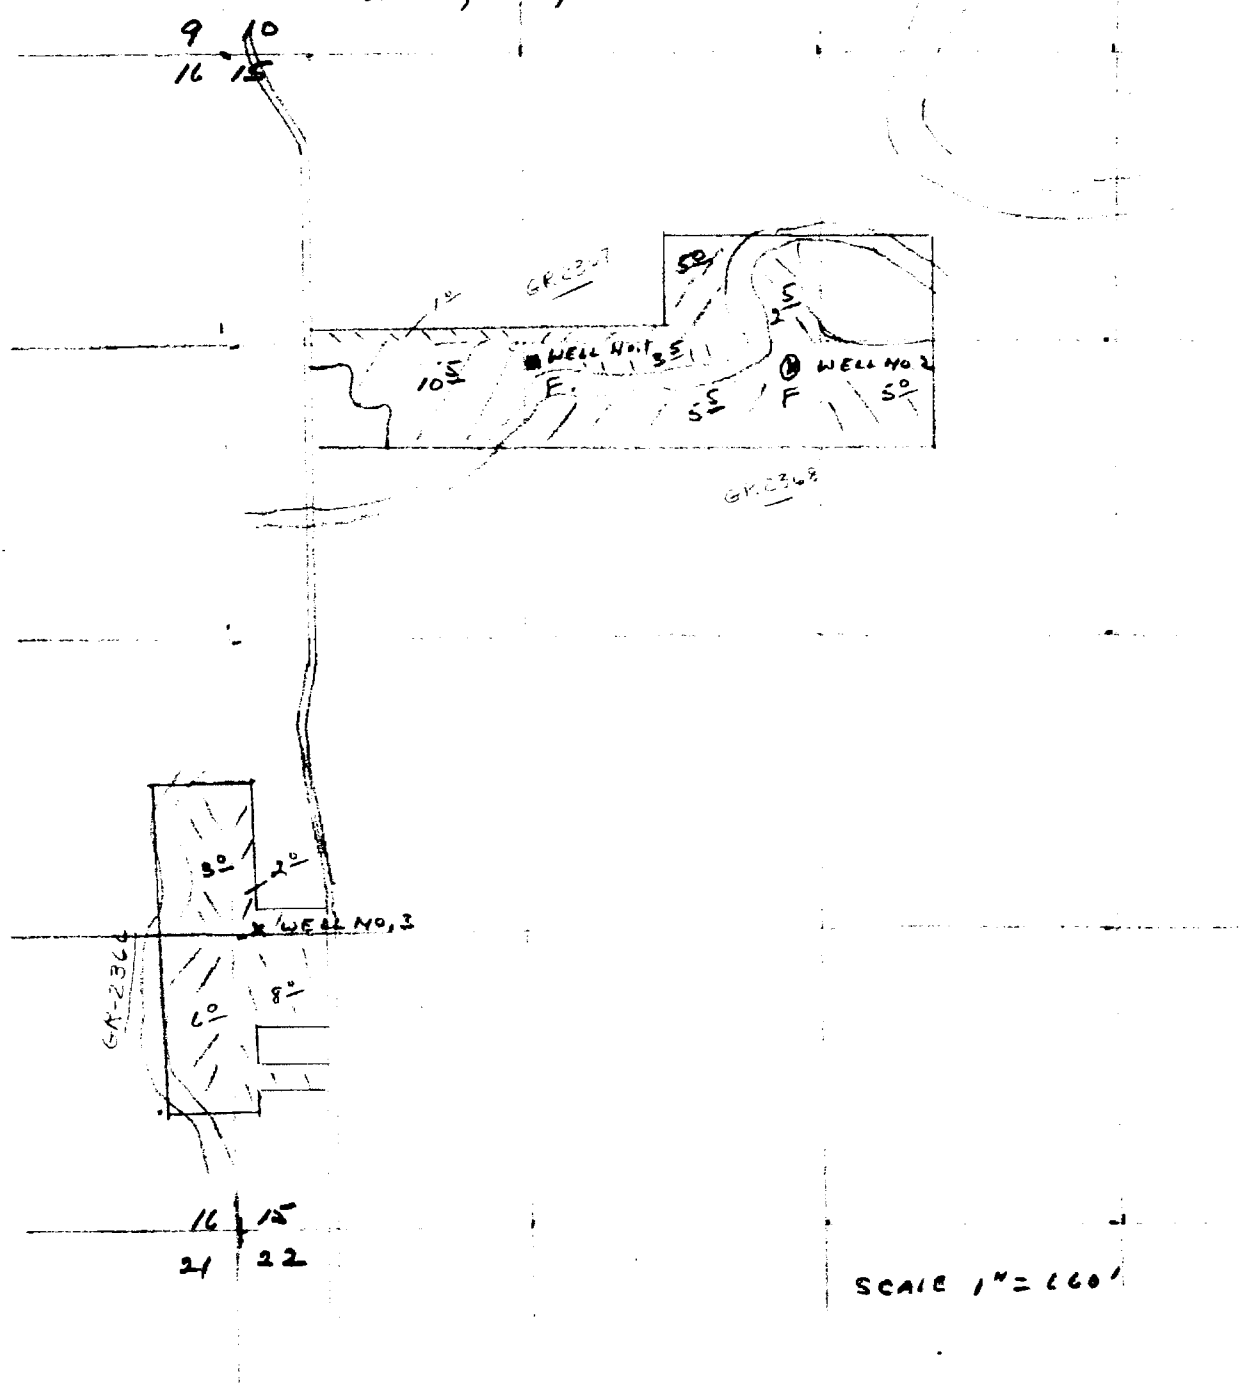

SCALE 1" = 660'