


11 12  
14 13


J. B. Chapman  
# 2924  
4H-82  
# 12862  
4H-80

12 7  
13 18

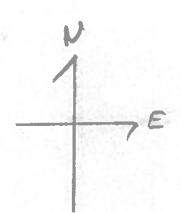

Scale 8" to mile

RECEIVED  
JUL 21 1958  
STATE ENGINEER  
SALEM, OREGON

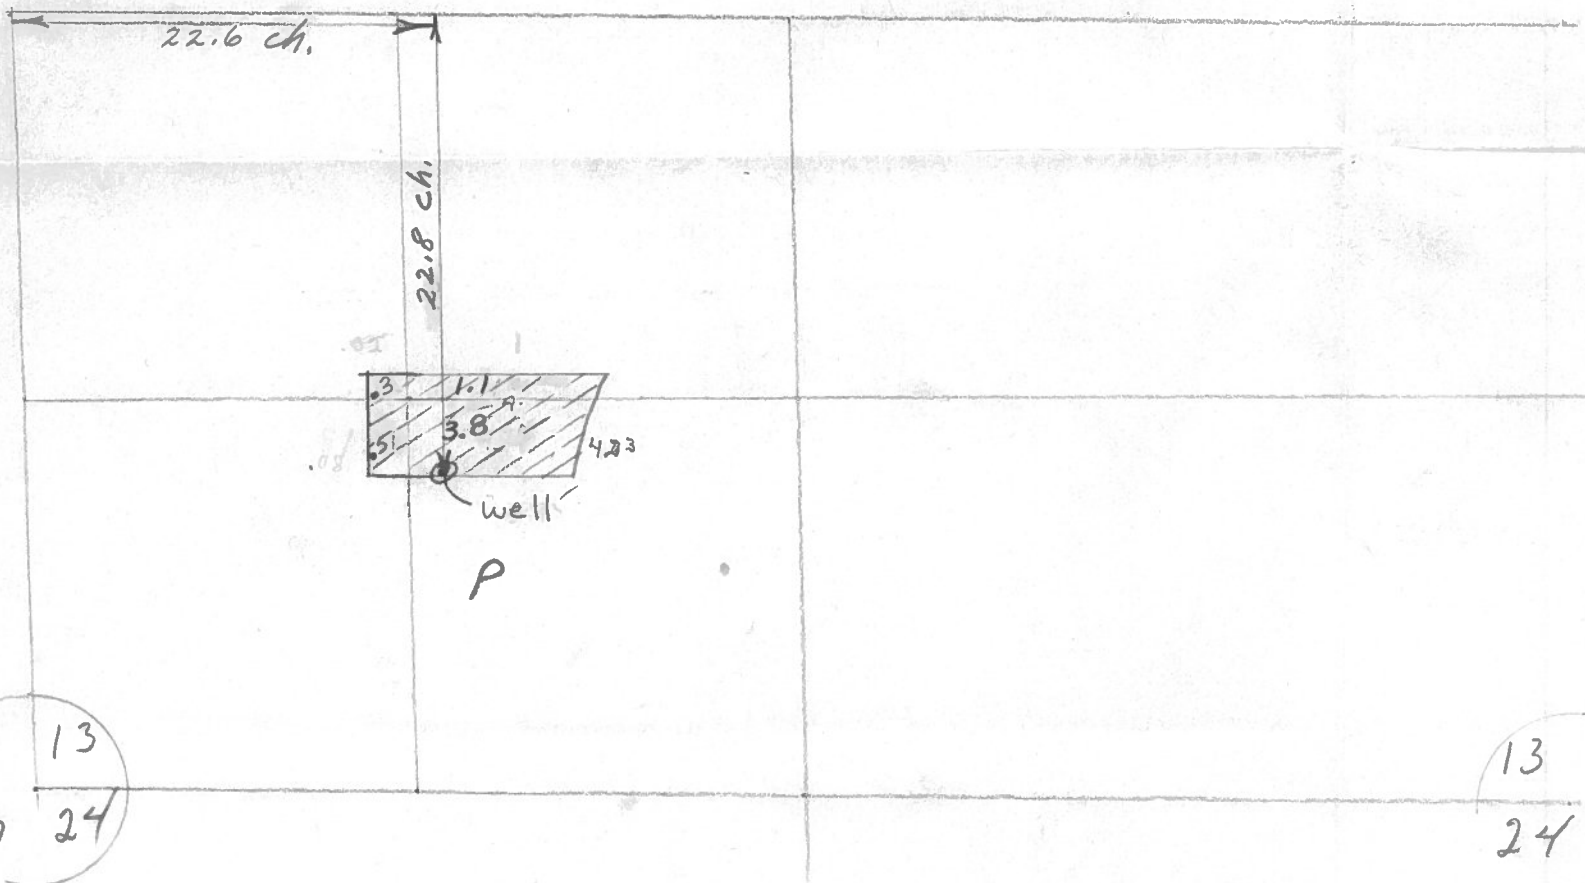

14 13  
23 24

13 18  
24 19

GR-2371