


R.P. RICHARDSON  
RT. 2, BOX 385, ALBANY, ORE.  
S. 20, T. 105, R. 2 W

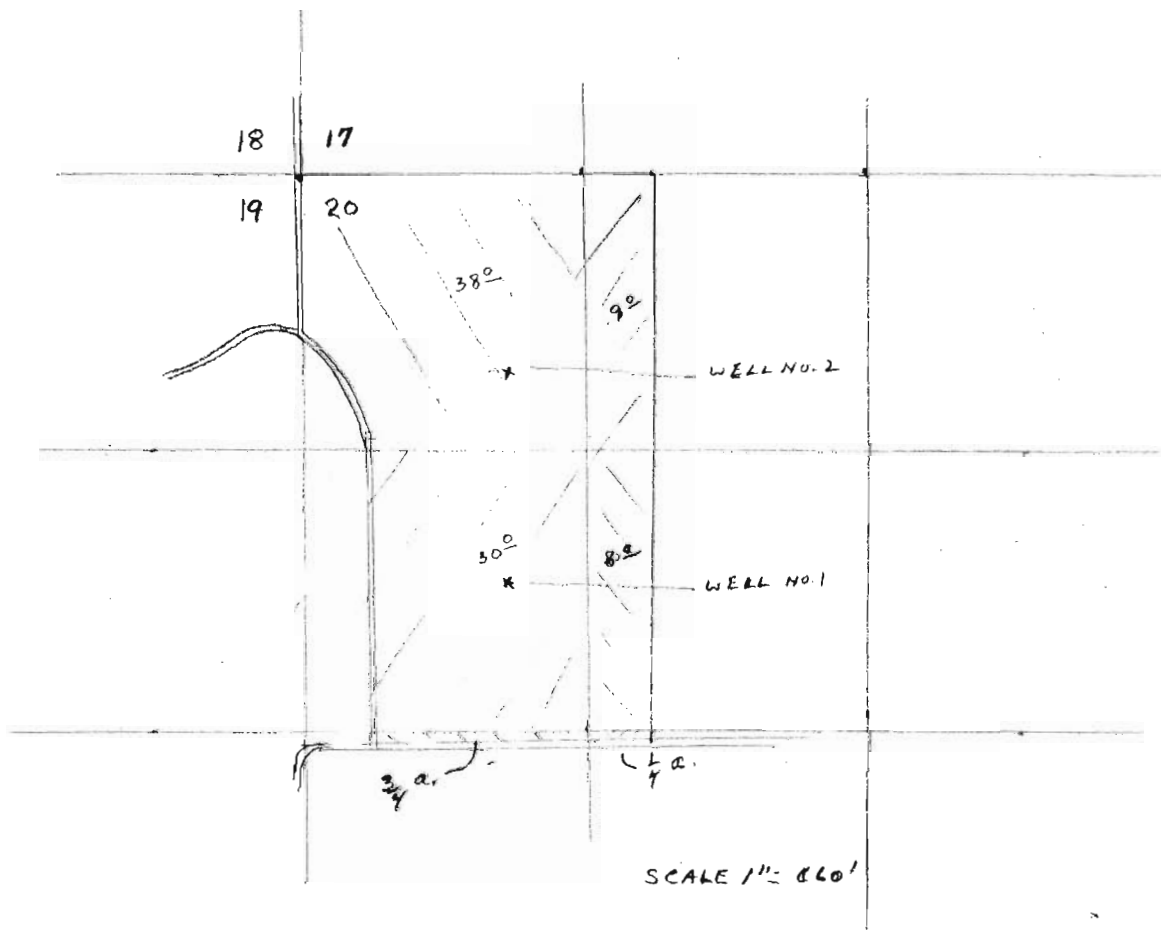

**RECEIVED**  
DEC 06 2007  
WATER RESOURCES DEPT  
SALEM, OREGON

GR-2391  
±  
GR-2392