






T.4S. R.1W. Sec. 22 & 23, W.M.

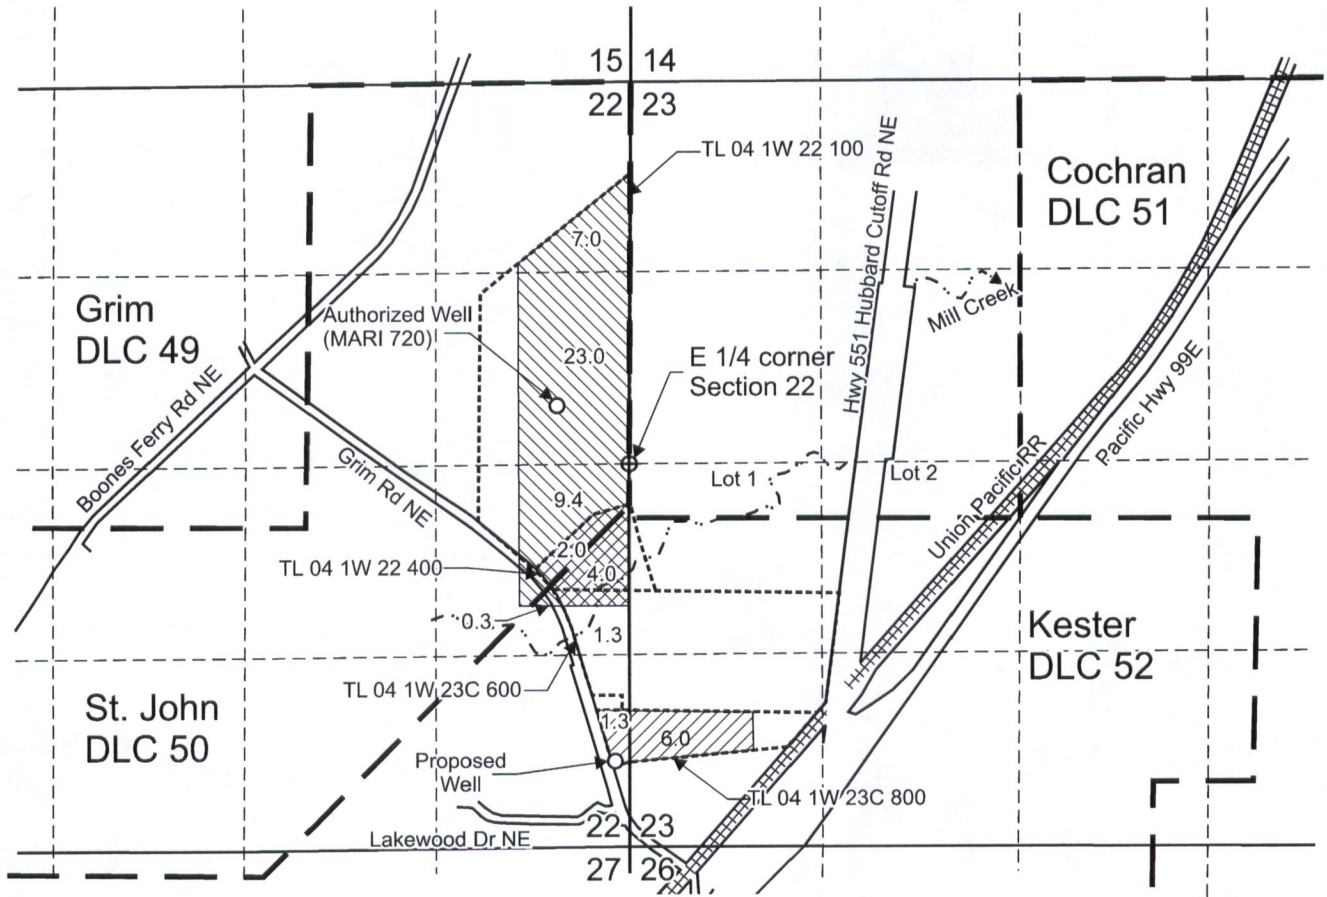


Authorized Well (MARI 720) is located 400 feet north and 500 feet west from the E 1/4 corner, Section 22.
 Proposed Well is located 595 feet north and 100 feet west from the SE corner, Section 22.

-  Area (39.7 Acres) irrigated under GR-2447, priority date 5-2-1952, not affected by this transfer
-  "From" Area (7.3 Acres) irrigated under GR-2447, priority date 5-2-1952, affected by this transfer
-  "To" Area (7.3 Acres) to be irrigated

-  Tax lot boundary
-  Donation Land Claim boundary

RECEIVED

JUN 29 2018

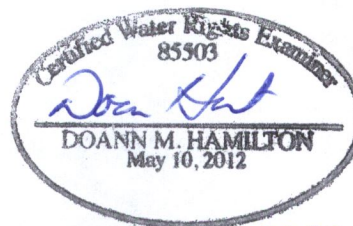

JUNE 30 2019

Scale: 1" = 1,320'



OWRD

This map was prepared for the purpose of identifying the location of a water right only and is not intended to provide legal dimensions or location of property ownership lines.




Groundwater Registration Modification Map
 GR-2447

Bruce Ernst
 T.4S. R.1W. Sec. 22 & 23, W.M.

Pacific Hydro-Geology Inc.

04/2018

Township 4.5 Range 1 W, W.M.
North

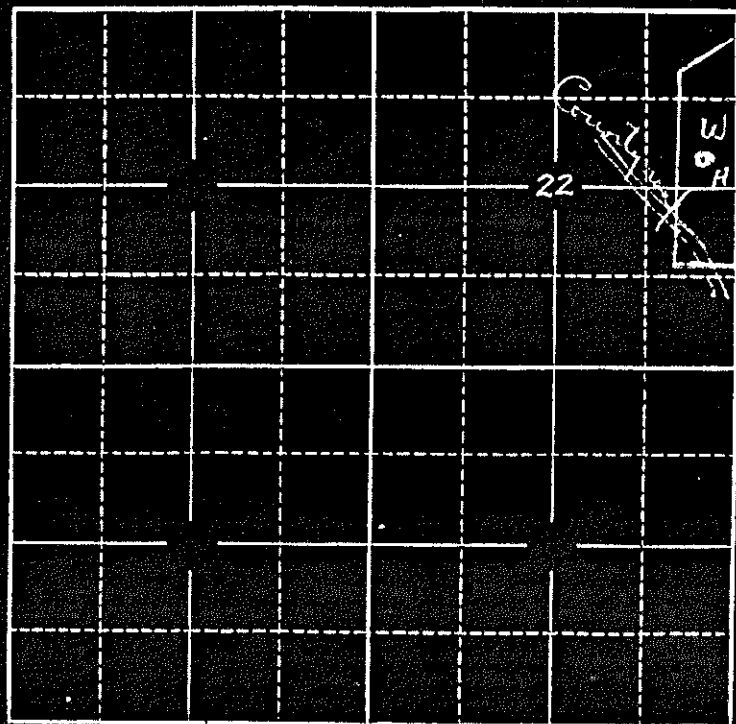

SECT 22
4-1W
E/2 of E/2
DAN. ST. JOHN
DLC-50

50.25 AC
V. 21 P. 345

Locate well and acreage of irrigated land on plat.

Scale: 2" = 1 Mile

STATE OF OREGON

County of Clackamas } ss.

I, D. J. Davis, being first duly sworn, do hereby certify that I have read the foregoing Registration Statement and that all of the items therein contained are true to the best of my knowledge and belief.


D. J. Davis
(Signature of Registrant)

Subscribed and sworn to before me this 21st day of July, 1958

My commission expires Jan 29 1961

Edw. A. Fetterman
(Notary Public)

Township 45 Range 1 W, W.M.
North

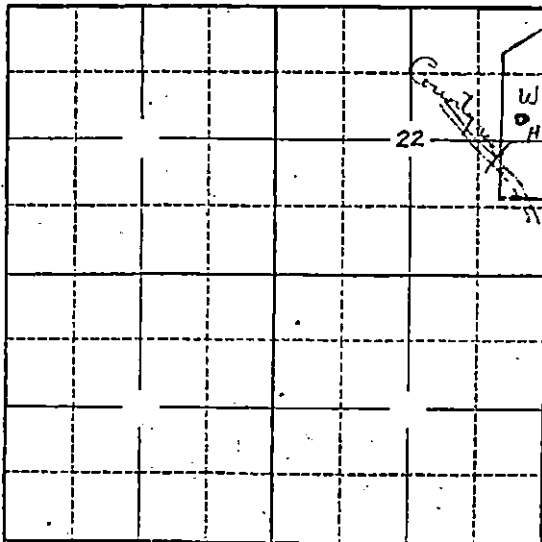

SECT 22
4-1W
E/2 of E/2
D.A.N. ST. JOHN
DEC-50

50.25 A
V. 21 1. 51

Locate well and acreage of irrigated land on plat.

Scale: 2" = 1 Mile

STATE OF OREGON

County of Clackamas ss.

I, Earl Davis, being first duly sworn, do hereby certify that I have read the foregoing Registration Statement and that all of the items therein contained are true to the best of my knowledge and belief.

Earl Davis
(Signature of Registrant)

Subscribed and sworn to before me this 21st day of July, 1950

My commission expires Jan 29 1961 Edw. A. Fetterman
(Notary Public)