


LOUIS W. AND ZOLA HAMLIN
S. 7, T. 12S, R. 4W

RECEIVED
JUL 21 1936
STATE ENGINEER
SALEM, OREGON

6 5
7 8

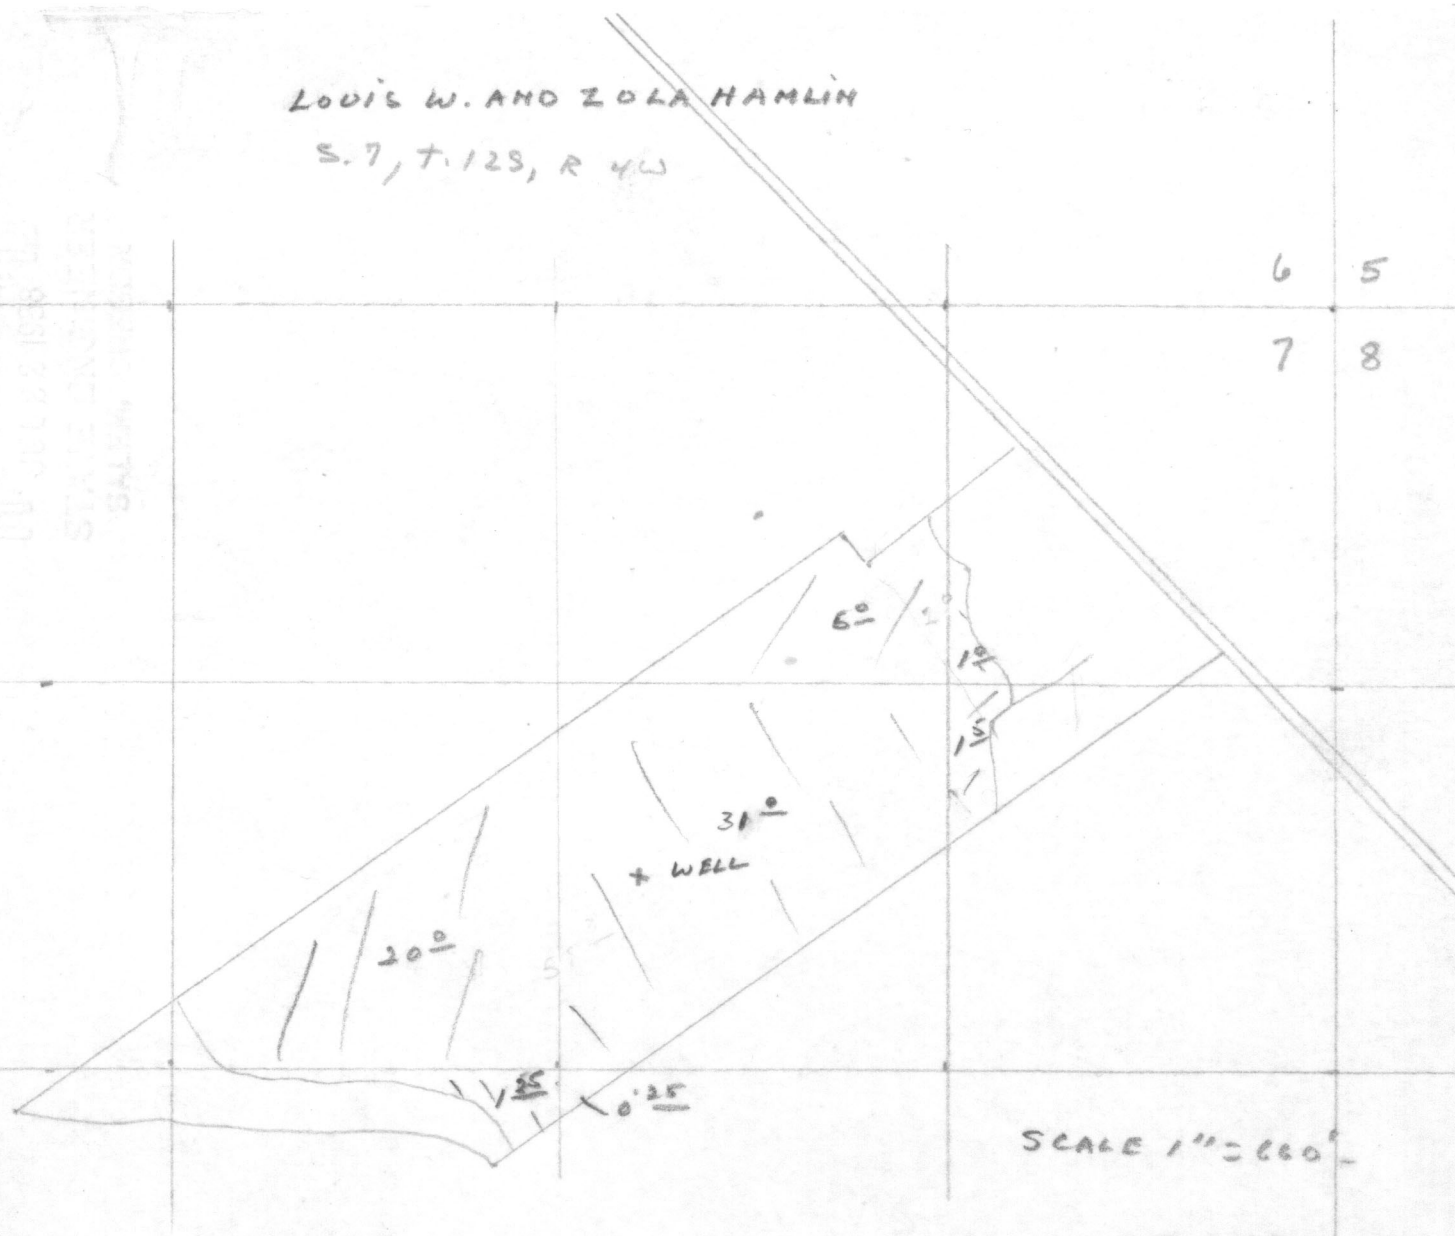

SCALE 1" = 660'

GR 2451