

RECEIVED
JUL 22 1958


3D-120

STATE ENGINEER
SALEM, OREGON

S. 30, T. 10S, R. 2W

24 19
25 30

N

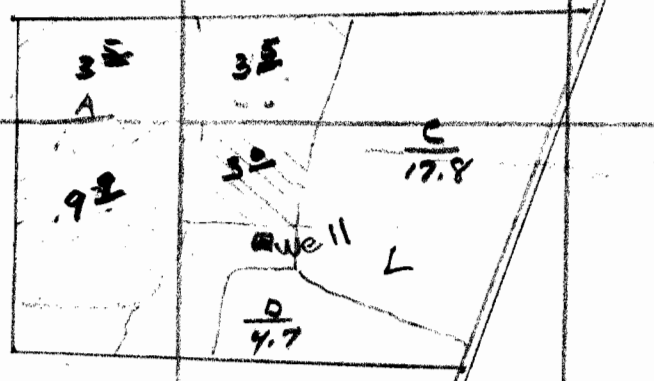

25 30
36 31

GR-2458