


S. 20, T. 11 S., R. 1 W.

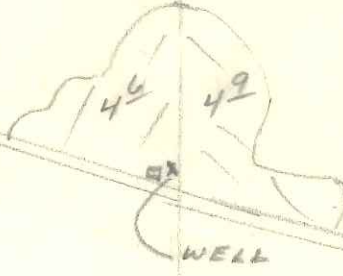

20 21

29 28

RECEIVED
JUL 2 1950
STATE ENGINEER
SALEM, OREGON