GR-248

W.R. 373

WILLIAM UPPSTAD

SECS. 8 & 9, T. 10 S., R. 2 W., W.M.

LINN COUNTY, OREGON

Scale: 1" = 10 Chains July 27, 1956

ORRIS A. CARNEGIE

DEP. CO. SURVEYOR

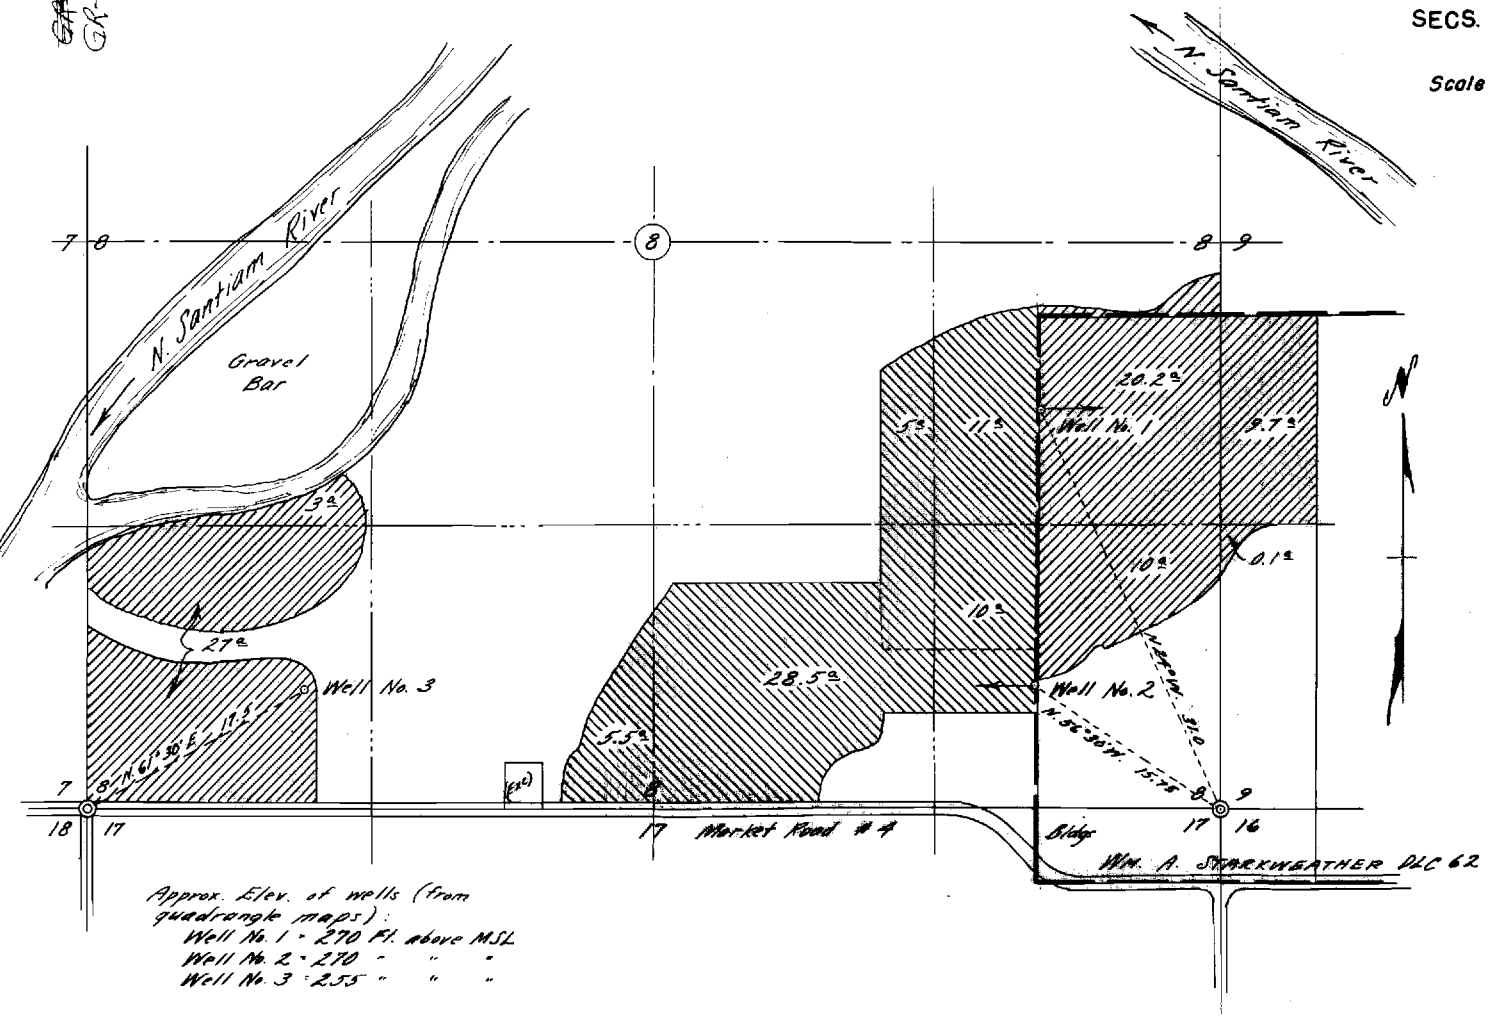

Approx. Elev. of wells (from quadrangle maps):

Well No. 1 = 270 Ft. above MSL

Well No. 2 = 270 " " "

Well No. 3 = 255 " " "

REGISTERED
OREGON
LAND SURVEYOR

Orris A. Carnegie

MAY 9, 1947

ORRIS A. CARNEGIE
213