Township T 41 S Range 13 W, W.M.

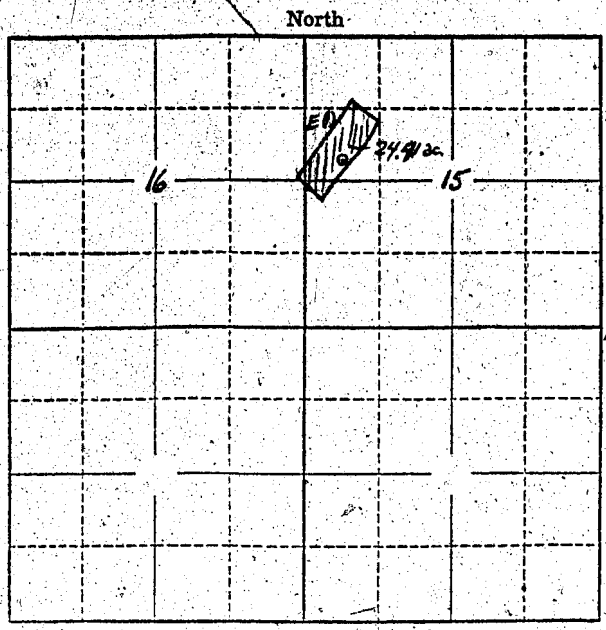

ATTACHED

Locate well and acreage of irrigated land on plat.

Scale: 2" = 1 Mile

STATE OF OREGON
County of Curry } ss.

I, A.K. Hartung, being first duly sworn, do hereby certify that I have read the foregoing Registration Statement and that all of the items therein contained are true to the best of my knowledge and belief.

A.K. Hartung
(Signature of Registrant)

Subscribed and sworn to before me this 14th day of August, 1956.

My commission expires April 19, 1960 Nancy C. Rasmussen
(Notary Public)

(SEAL)

CERTIFICATE OF REGISTRATION

STATE OF OREGON
County of Marion } ss.

This is to certify that the foregoing Registration Statement was received in the office of the State Engineer on the 5th day of September, 1956, at 2:45 o'clock P. M. and has been duly recorded in said office in Book No. 2 of Registration Statements on page GR-232 C

~~Certificate shall be completed by writing in the date when permit applied for is issued by writing in the date when permit expires.~~

Witness my hand this 15th day of January, 1957.

Lewis A. Stanley
(State Engineer)

By
(Deputy)

GR-232 C