


North

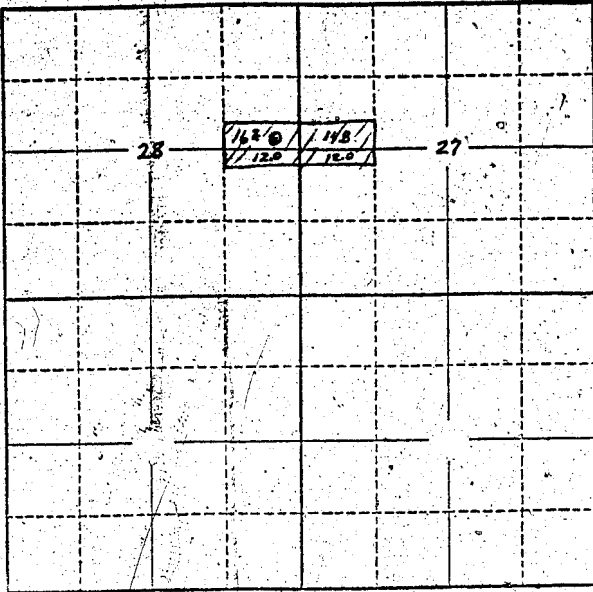

Locate well and acreage of irrigated land on plat.

Scale: 2" = 1 Mile

STATE OF OREGON

County of Marion } ss.

I, Harwin W. Coffey, being first duly sworn, do hereby certify that I have read the foregoing Registration Statement and that all of the items therein contained are true to the best of my knowledge and belief.

Harwin W. Coffey
(Signature of Registrant)

Subscribed and sworn to before me this January 23 day of 1957

MY COMMISSION EXPIRES DEC. 31, 1958

My commission expires _____

Walter Schuber
(Notary Public)

(SEAL)

CERTIFICATE OF REGISTRATION

STATE OF OREGON

County of Marion } ss.

This is to certify that the foregoing Registration Statement was received in the office of the State Engineer on the 12th day of September, 1956, at 4:30 o'clock P. M. and has been duly recorded in said office in Book No. 2 of Registration Statements on page GR-234-C

~~Consent has been completed by _____ and the water completely applied to _____~~

Witness my hand this 15th day of January, 1957

Lewis A. Stanley
(State Engineer)

By _____ (Deputy)

GR-234-C