Township 1N Range 2W, W.M.

North

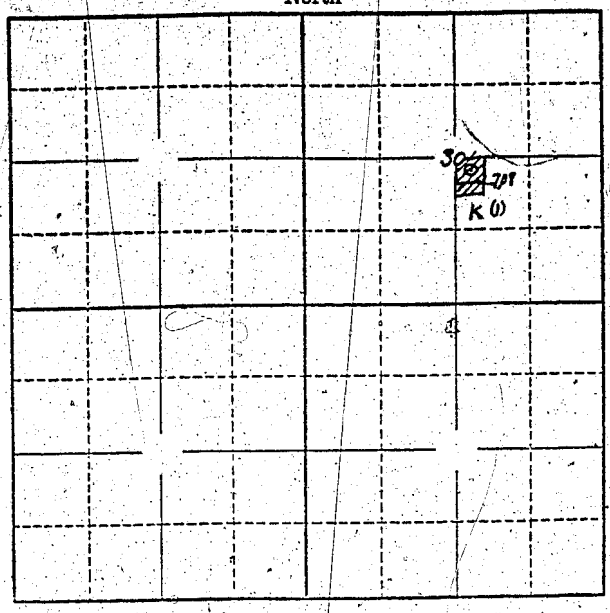

Map in G-455

Locate well and acreage of irrigated land on plat.

Scale: 2" = 1 Mile

STATE OF OREGON
County of Washington } ss.

We C. W. Wright & Lucille Wright, being first duly sworn, do hereby certify that I have read the foregoing Registration Statement and that all of the items therein contained are true to the best of my knowledge and belief.

C. W. Wright
Lucille Wright
(Signature of Registrant)

Subscribed and sworn to before me this 17th day of Sept, 19 0-

My commission expires 10/12/57

Jeanette Nelson
(Notary Public)

(SEAL)

CERTIFICATE OF REGISTRATION

STATE OF OREGON
County of Marion } ss.

This is to certify that the foregoing Registration Statement was received in the office of the State Engineer on the 20th day of September, 19 56, at 8 o'clock A. M. and has been duly recorded in said office in Book No. 2 of Registration Statements on page GR-239-C.

~~Construction to be completed by X-X-X-X-X-X-X-X-X-19X-X and the water completely applied to beneficial use by X-X-X-X-X-X-X-X-X-19-X-~~

Witness my hand this 15th day of January, 19 57

Lewis A. Stanley
(State Engineer)

By
(Deputy)

GR-239C