Township 11 S Range 2 W, W.M.

North

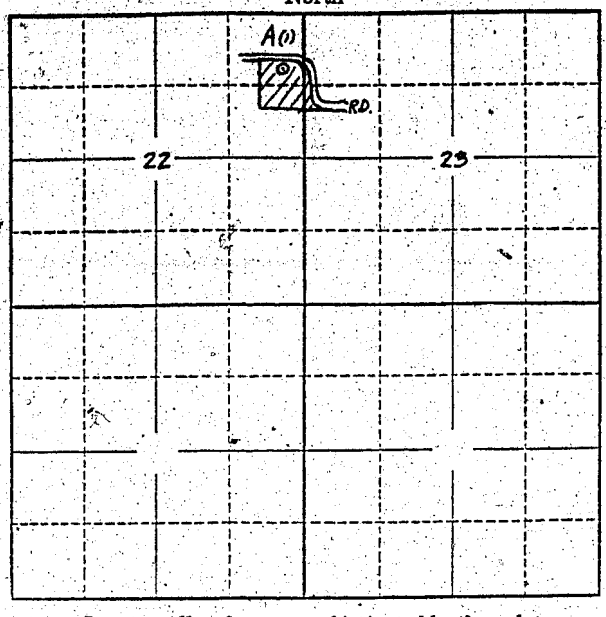

Locate well and acreage of irrigated land on plat.

Scale: 2" = 1 Mile

STATE OF OREGON
County of Linn } ss.

I, Myrtle Donovan, being first duly sworn, do hereby certify that I have read the foregoing Registration Statement and that all of the items therein contained are true to the best of my knowledge and belief.

Myrtle Donovan
(Signature of Registrant)

Subscribed and sworn to before me this 19th day of Sept, 1956

My commission expires Dec 23 1959

(Notary Public)

(SEAL)

CERTIFICATE OF REGISTRATION

STATE OF OREGON
County of Marion } ss.

This is to certify that the foregoing Registration Statement was received in the office of the State Engineer on the 24th day of September, 1956, at 3 o'clock P. M. and has been duly recorded in said office in Book No. 2 of Registration Statements on page GR-242-C

~~Construction should be completed by X-X-X-X-X-X-X-X-X-19X-X, and be completed to apply to X-X-X-X-X-X-X-X-X-