


North

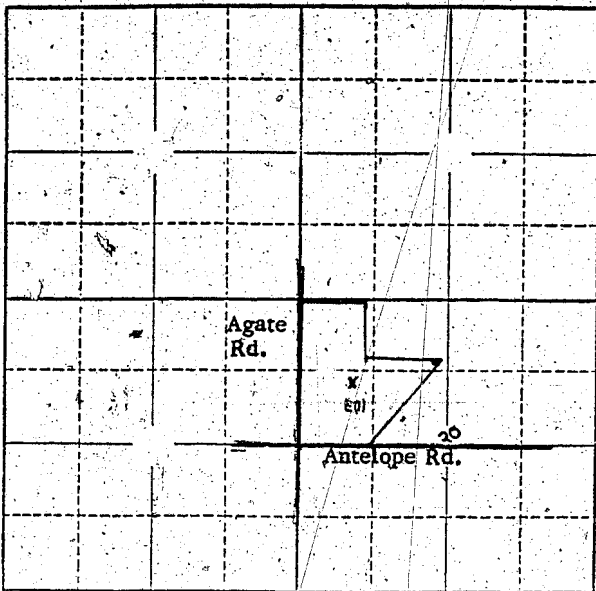

Locate well and acreage of irrigated land on plat.

Scale: 2" = 1 Mile

State of Oregon)
) ss.
 County of Jackson)

I, Frank G. Martin, being first duly sworn, depose and say that I am the assistant secretary of Olson-Ross Lumber Co., Inc., an Oregon corporation, having its principal offices in Medford, Jackson county, Oregon, and that I am duly authorized to make the above and foregoing registration statement of claimant of right to appropriate ground water for and on behalf of said corporation, and I do hereby certify that I have read the foregoing registration statement and that all of the items therein contained are true to the best of my knowledge and belief.

Frank G. Martin
 Frank G. Martin

Subscribed and sworn to before me this 20th day of September, 1956.

Henry Nelson
 Notary Public for Oregon
 My commission expires 12-1-1957


SEE PAGE GR-244-G FOR
 CERTIFICATE OF REGISTRATION

STATE OF OREGON }
) ss.
 County of Marion }


(State Engineer)

By _____ (Deputy)

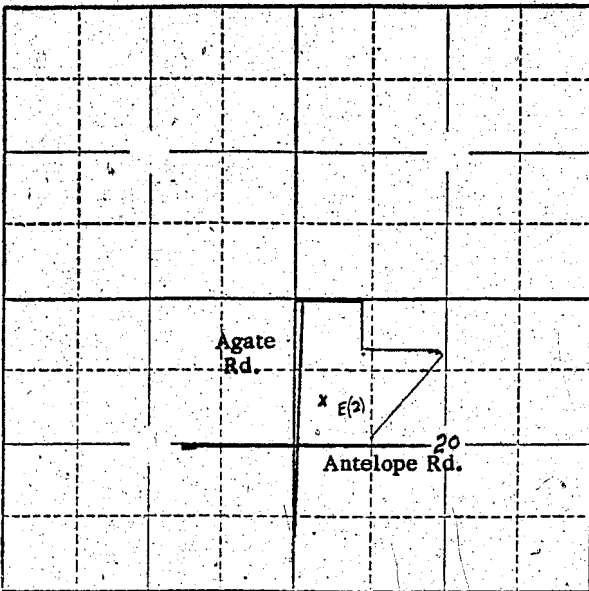

Locate well and acreage of irrigated land on plat.
Scale: 2" = 1 Mile

State of Oregon)
) ss.
County of Jackson)

I, Frank G. Martin, being first duly sworn, depose and say that I am the assistant secretary of Olson-Ross Lumber Co., Inc., an Oregon corporation, having its principal offices in Medford, Jackson county, Oregon, and that I am duly authorized to make the above and foregoing registration statement of claimant of right to appropriate ground water for and on behalf of said corporation, and I do hereby certify that I have read the foregoing registration statement and that all of the items therein contained are true to the best of my knowledge and belief.

Frank G. Martin
Frank G. Martin

Subscribed and sworn to before me this 26th day of September, 1956.

Notary Public for Oregon
My commission expires July 1957

CERTIFICATE OF REGISTRATION

STATE OF OREGON }
County of Marion } ss.

This is to certify that the foregoing Registration Statement was received in the office of the State Engineer on the 27th day of September, 1956, at 10:30 o'clock A. M. and has been duly recorded in said office in Book No. 2 of Registration Statements on page GR-244-9.



Witness my hand this 15th day of January, 1957.

Stewart J. Stanley
(State Engineer)

By _____
(Deputy)