


28 27

33 34

IRA BECKLER

S. 34, T. 11 S., R. 2 W.

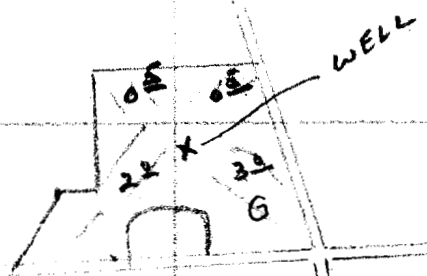

SCALE 1" = 660'

GR-2670