


Township 1 SOUTH Range 1 WEST W.M.  
North

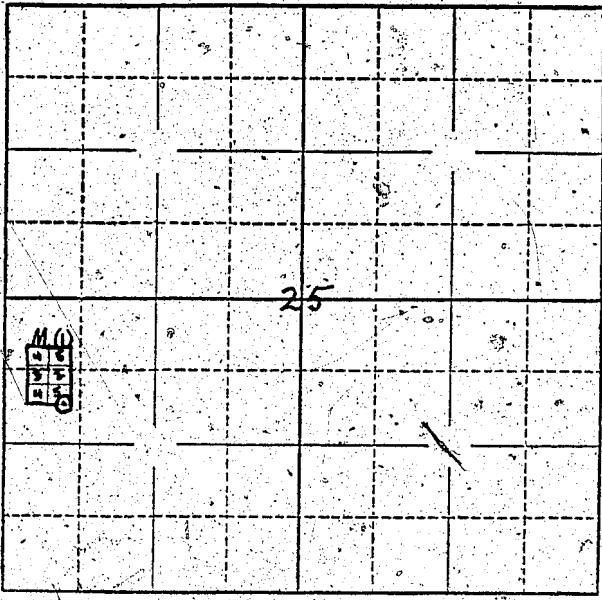

SEE MAP  
METZGER ACRES  
ATTACHED

~~DO NOT HAVE  
THIS DATA  
AVAILABLE  
IDENTIFIED BY  
METZGER CLOS  
DESCRIPTION~~

Locate well and acreage of irrigated land on plat.  
Scale:  $\frac{1}{4}$ " = 1 Mile

STATE OF OREGON

County of Washington } ss.

I, Wm. Forsyth, being first duly sworn, do hereby certify that I have read the foregoing Registration Statement and that all of the items therein contained are true to the best of my knowledge and belief.

Wm. Forsyth  
(Signature of Registrant)

Subscribed and sworn to before me this 6 day of October, 1955

My commission expires J. K. Park

(SEAL)

NOTARY PUBLIC FOR OREGON  
COMMISSION EXPIRES AUGUST 25, 1956

**CERTIFICATE OF REGISTRATION**

STATE OF OREGON

County of Marion } ss.

This is to certify that the foregoing Registration Statement was received in the office of the State Engineer on the 12th day of October, 1955, at 8:00 o'clock A. M. and has been duly recorded in said office in Book No. 1 of Registration Statements on page 23

Construction <sup>is</sup> shall be completed by 1956, and the water <sup>is</sup> completely applied to beneficial use by 1956

Witness my hand this 24th day of February, 1956.  
Lewis A. Stanley  
(State Engineer)

By \_\_\_\_\_  
(Deputy)