Township 6 S Range 3 W, W.M.

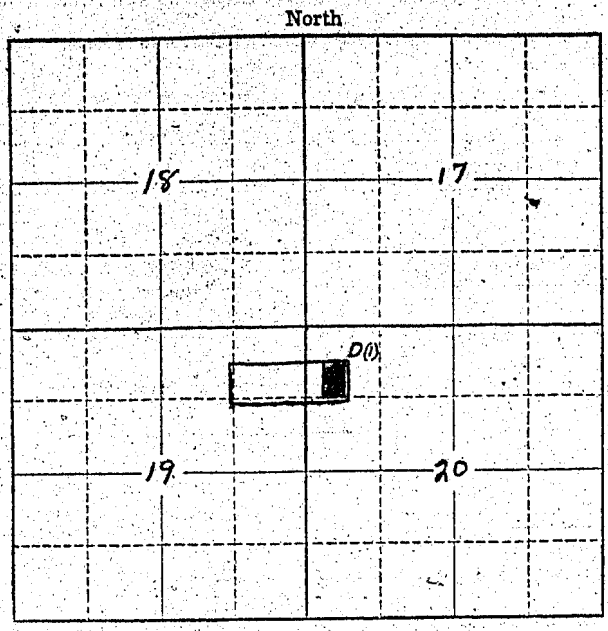

Dot shows Location of well & area in Red will be irrigated.

Locate well and acreage of irrigated land on plat.

Scale: 2" = 1 Mile

STATE OF OREGON
County of Marion } ss.

I, Loren E. Powell, being first duly sworn, do hereby certify that I have read the foregoing Registration Statement and that all of the items therein contained are true to the best of my knowledge and belief.

Loren E. Powell
(Signature of Registrant)

Subscribed and sworn to before me this 12th day of October, 1956

My commission expires April 6, 1959 W M Blinn
(Notary Public)

(SEAL)

CERTIFICATE OF REGISTRATION

STATE OF OREGON
County of Marion } ss.

This is to certify that the foregoing Registration Statement was received in the office of the State Engineer on the 12th day of October, 1956, at 10 o'clock A. M. and has been duly recorded in said office in Book No. 2 of Registration Statements on page GR-248-C

~~Construction shall be completed by x x x x x x x x x x 19 x x and the work x complete x applied x to beneficial use x x x x x x x x x x x x x x x~~

Witness my hand this 15th day of January, 1957

Lewis A. Stanley
(State Engineer)

By
(Deputy)

GR-248C