


**WATER RIGHT MAP FOR  
FRED KNOX  
SEC. 10 & 15 T17S, R3W**

NOTE: THIS MAP MADE  
FROM RECORDS & INFOR-  
MATION FURNISHED BY THE  
APPLICANT & NOT FROM A  
SURVEY.

F. E. WAGGONER

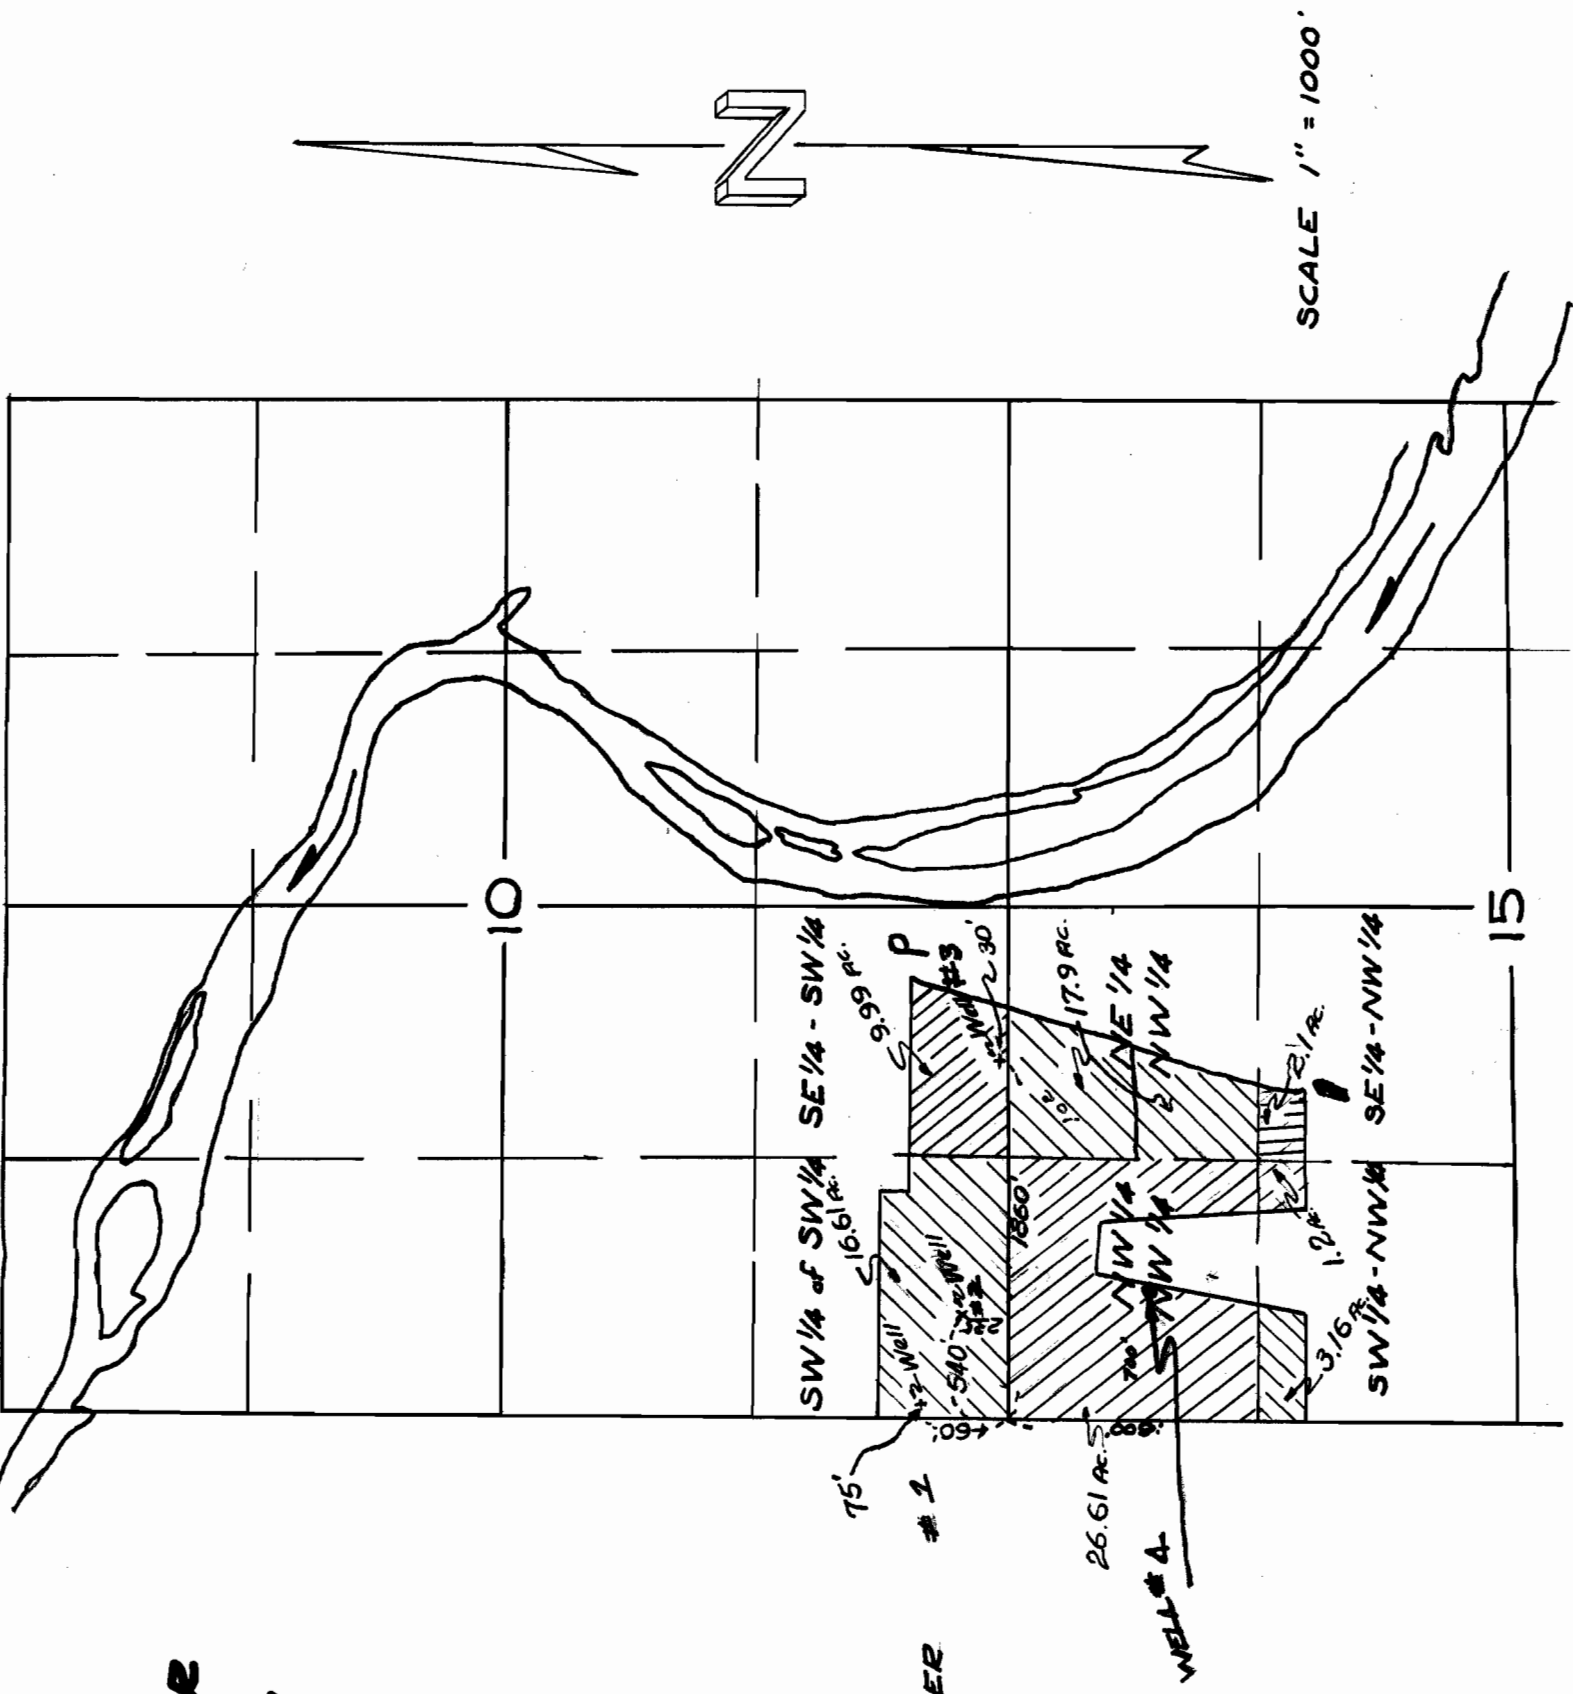

2700