


R3W

R2W

25 30  
36 31

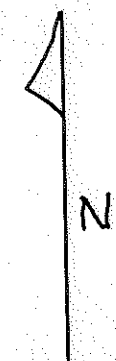

T4S

WELL LOCATION

SCALE 1" = 660'

J.W. RICHARDSON

CB 2702