


North

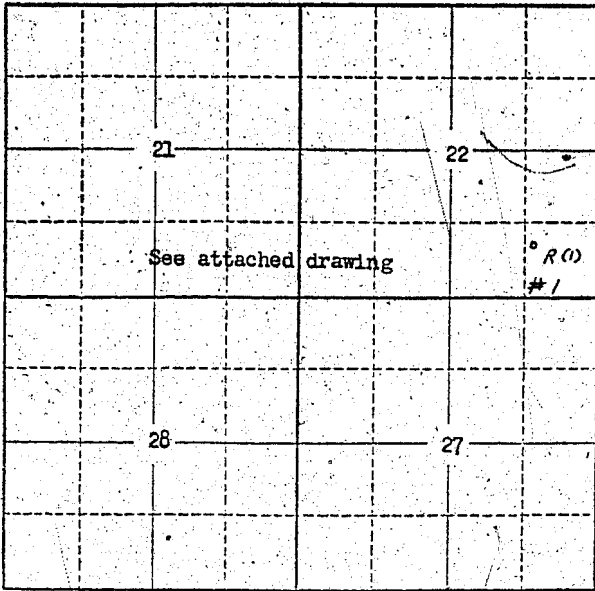

Locate well and acreage of irrigated land on plat.

Scale: 2" = 1 Mile

STATE OF OREGON

Benton

County of

} ss.

John F. Porter (City Manager)

I, being first duly sworn, do hereby certify that I have read the foregoing Registration, Statement and that all of the items therein contained are true to the best of my knowledge and belief.

John F. Porter
(Signature of Registrant)

Subscribed and sworn to before me this 4th day of October, 1956

My commission expires March 13, 1959

[Signature]
(Notary Public)

(SEAL)

SEE PAGE GR-289-K FOR CERTIFICATE OF REGISTRATION

STATE OF OREGON

County of Marion

} ss.

~~This is to certify that the foregoing Registration Statement was received in the office of the State Engineer on the ... day of ... 19... and has been duly recorded in Book No. ... of the State of Oregon. Construction shall be completed by ...~~


(State Engineer)

By

(Deputy)

GR-289C

North

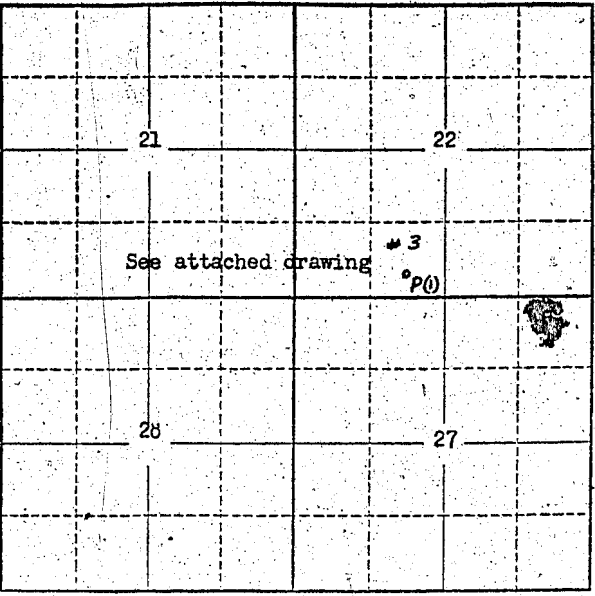

Locate well and acreage of irrigated land on plat.
Scale: 2" = 1 Mile

STATE OF OREGON

County of Benton } ss.

I, John F. Porter (City Manager) being first duly sworn, do hereby certify that I have read the foregoing Registration Statement and that all of the items therein contained are true to the best of my knowledge and belief.

John F. Porter
(Signature of Registrant)

Subscribed and sworn to before me this 4th day of October, 1956

My commission expires March 13, 1959 *[Signature]*
(Notary Public)

(SEAL)

SEE PAGE GR-289-K FOR
CERTIFICATE OF REGISTRATION

STATE OF OREGON

County of Marion } ss.




(State Engineer)

By _____
(Deputy)

		21		22	
					6 J 6
		See attached drawing			
		28		27	

Locate well and acreage of irrigated land on plat.
Scale: 2" = 1 Mile

STATE OF OREGON

County of Benton

ss.

I, John F. Porter (City Manager), being first duly sworn, do hereby certify that I have read the foregoing Registration Statement and that all of the items therein contained are true to the best of my knowledge and belief.

John F. Porter
(Signature of Registrant)

Subscribed and sworn to before me this 4th day of October, 1956

My commission expires March 13, 1959

[Signature]
(Notary Public)

(SEAL)

CERTIFICATE OF REGISTRATION

STATE OF OREGON

County of Marion

ss.

This is to certify that the foregoing Registration Statement was received in the office of the State Engineer on the 12th day of October, 1956, at 9:30 o'clock A.M. and has been duly recorded in said office in Book No. 2 of Registration Statements on page GR-289-K

~~Construction shall be completed by X-X-X-X-X-X-X-X-X-X-X-X and the water completely repaired~~

~~by X-X-X-X-X-X-X-X-X-X-X-X~~

Witness my hand this 15th day of January, 1957

Lewis A. Stanley
(State Engineer)

By _____ (Deputy)