


North

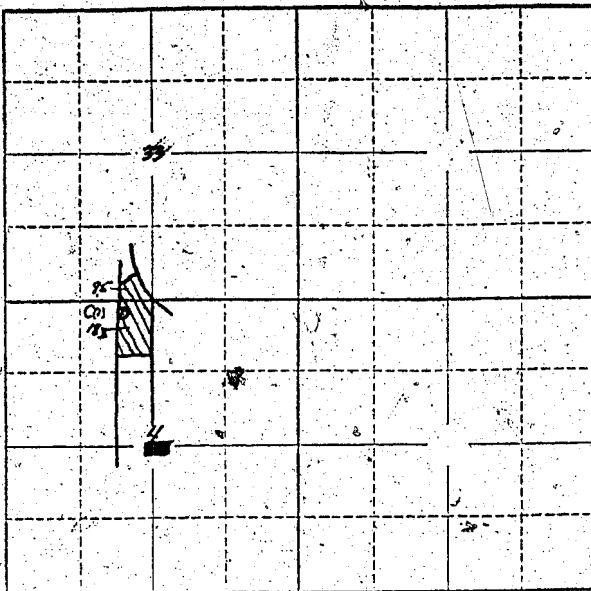

Locate well and acreage of irrigated land on plat.

Scale: 2" = 1 Mile

STATE OF OREGON

County of Linn } ss.

Caroline, George M., George B. I, and Gurney B. Haworth, being first duly sworn, do hereby certify that I have read the foregoing Registration Statement and that all of the items therein contained are true to the best of my knowledge and belief.

Caroline Haworth George M. Haworth
Geo B. Haworth Gurney B. Haworth
(Signature of Registrant)

Subscribed and sworn to before me this _____ day of _____, 19____.

My commission expires _____ (Notary Public)

(SEAL)

SEE PAGE GR-252-G FOR CERTIFICATE OF REGISTRATION

STATE OF OREGON

County of Marion } ss.

~~This is to certify that the foregoing Registration Statement was received in the office of the State Engineer on the _____ day of _____ 19____ and that the water completely applied to~~

~~the _____ acreage of the _____ District of the State of Oregon _____~~

Witness my hand this _____ day of _____, 19____.

(State Engineer)

By _____ (Deputy)

