

North

		A) 67		
		(Sec 21)	(Sec 22)	

(Sump No. 1
on accompanying

Locate well and acreage of irrigated land on plat.
Scale: 2" = 1 Mile

STATE OF OREGON

County of Jackson } ss.

I, Kathryn Hanley Heffernan, being first duly sworn, do hereby certify that I have read the foregoing Registration Statement and that all of the items therein contained are true to the best of my knowledge and belief.

Kathryn Hanley Heffernan
(Signature of Registrant)

Subscribed and sworn to before me this 23rd day of October 1956

My commission expires Aug 30, 1959 Edward B. Ravehfield
(Notary Public)

(SEAL)

SEE PAGE GR-290-0 FOR
CERTIFICATE OF REGISTRATION

STATE OF OREGON

County of Marion } ss.


~~This is to certify that the foregoing Registration Statement was received in the office of the State Engineer on the X-X-X-X day of X-X-X-X 19X-X at X-X-X-X and has been duly recorded in accordance with the provisions of the Registration Act and that the same shall be complete by X-X-X-X 19X-X and that the State Engineer is not a party to the same.~~

Witness my hand this day of 19.....

(State Engineer)

By
(Deputy)

North

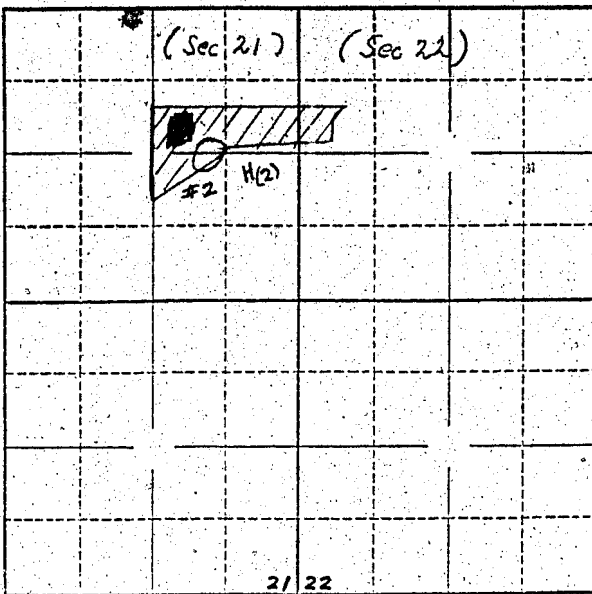

(Sump No. 2 on accompanying map)

Locate well and acreage of irrigated land on plat.

Scale: 2" = 1 Mile

STATE OF OREGON

County of Jackson } ss.

I, Kathryn Hanley Heffernan, being first duly sworn, do hereby certify that I have read the foregoing Registration Statement and that all of the items therein contained are true to the best of my knowledge and belief.

Kathryn Hanley Heffernan
(Signature of Registrant)

Subscribed and sworn to before me this 23rd day of October, 1956

My commission expires August 20, 1959.

Edward Branchfield
(Notary Public)

(SEAL)

SEE PAGE GR-290-0 FOR CERTIFICATE OF REGISTRATION.

STATE OF OREGON

County of Marion } ss.



Witness my hand this _____ day of _____, 19_____

(State Engineer)
By _____
(Deputy)

North

	(Sec 21)	(Sec 22)		

(Sump No. 3 on accompanying map)

Locate well and acreage of irrigated land on plat.

Scale: 2" = 1 Mile

STATE OF OREGON

County of Jackson } ss.

I, Katheryn Hanley Heffernan, being first duly sworn, do hereby certify that I have read the foregoing Registration Statement and that all of the items therein contained are true to the best of my knowledge and belief.

Katheryn Hanley Heffernan
(Signature of Registrant)

Subscribed and sworn to before me this 23rd day of October, 1956

My commission expires August 20, 1959

Edward Brandt
(Notary Public)

(SEAL)

SEE PAGE GR-290-O FOR
CERTIFICATE OF REGISTRATION.

STATE OF OREGON

County of Marion } ss.

~~This is to certify that the foregoing Registration Statement was received in the office of the State Engineer on the ... of ... and that all of the items therein contained are true to the best of my knowledge and belief.~~

Witness my hand this _____ day of _____, 19_____

(State Engineer)

By _____
(Deputy)

