


North

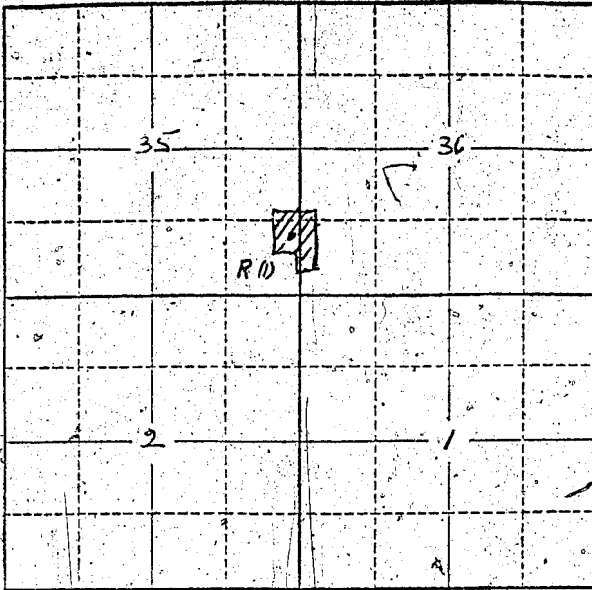

Locate well and acreage of irrigated land on plat.

Scale: 2" = 1 Mile

STATE OF OREGON

County of Linn } ss.

I, D. H. Morris and Zerma L. Morris being first duly sworn, do hereby certify that I have read the foregoing Registration Statement and that all of the items therein contained are true to the best of my knowledge and belief.

D. H. Morris
Zerma L. Morris
(Signature of Registrant)

Subscribed and sworn to before me this 23 day of October, 1956

My commission expires November 27, 1959 Stanley A. Wright
(Notary Public Oregon)

(SEAL)

CERTIFICATE OF REGISTRATION

STATE OF OREGON

County of Marion } ss.

This is to certify that the foregoing Registration Statement was received in the office of the State Engineer on the 26th day of October, 1956, at 11 o'clock A.M. and has been duly recorded in said office in Book No. 2 of Registration Statements on page GR-257-C

~~Construction shall be completed by xxxxxxxxxx and the water completely applied to xxxxxxxxxx~~

Witness my hand this 15th day of January, 1957

Stanley A. Stanley
(State Engineer)

By _____ (Deputy)