Township 11 S Range 2 W, W.M.

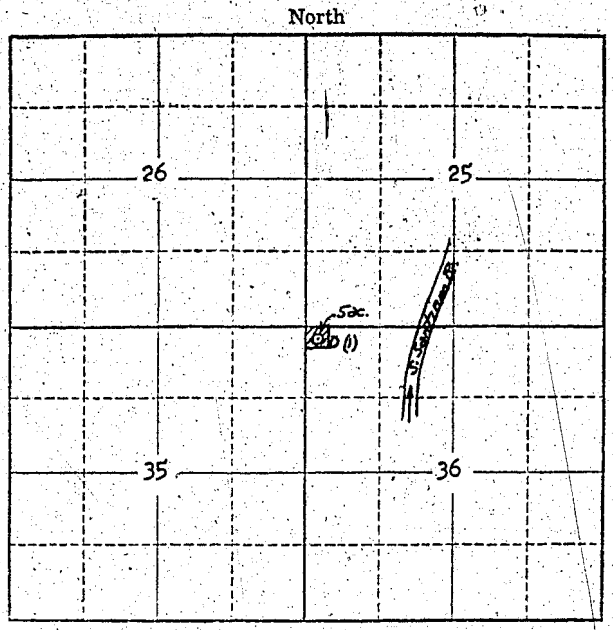

Locate well and acreage of irrigated land on plat.

Scale: 2" = 1 Mile

STATE OF OREGON
County of Linn } ss.

I, Charles A. and Wavell Jackson, being first duly sworn, do hereby certify that I have read the foregoing Registration Statement and that all of the items therein contained are true to the best of my knowledge and belief.

Wavell Jackson
Charles Jackson
(Signature of Registrant)

Subscribed and sworn to before me this 25th day of October, 1956

My commission expires .....

Ruth Russell, Clerk
Ted Margart, Deputy
(Notary Public)

(SEAL)

CERTIFICATE OF REGISTRATION

STATE OF OREGON
County of Marion } ss.

This is to certify that the foregoing Registration Statement was received in the office of the State Engineer on the 30th day of October, 1956, at 10 o'clock A.M. and has been duly recorded in said office in Book No. 2 of Registration Statements on page GR-259-C

~~Construction should be completed by ..... 19.....~~ ~~Water should be applied to beneficial use by ..... 19.....~~

Witness my hand this 15th day of January, 1957.

Lewis A. Stanley
(State Engineer)

By .....
(Deputy)

GR-259C