Township 26S Range 6W, W.M.

North

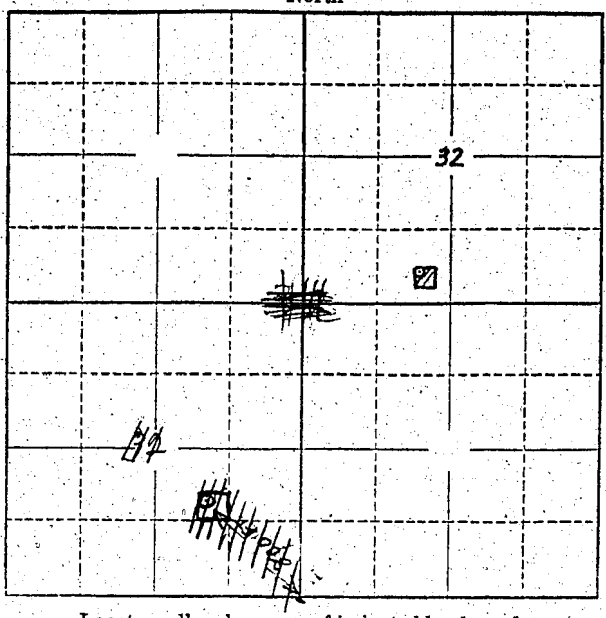

Locate well and acreage of irrigated land on plat.

Scale: 2" = 1 Mile

STATE OF OREGON
County of Douglas } ss.

I, A. B. Baird, being first duly sworn, do hereby certify that I have read the foregoing Registration Statement and that all of the items therein contained are true to the best of my knowledge and belief.

x A. B. Baird
(Signature of Registrant)

Subscribed and sworn to before me this 27 day of June, 1956

My commission expires .....

Chas Boerner
(Notary Public)
County Clerk

(SEAL)

CERTIFICATE OF REGISTRATION

STATE OF OREGON
County of Marion } ss.

This is to certify that the foregoing Registration Statement was received in the office of the State Engineer on the 5th day of November, 1956, at 8 o'clock A.M. and has been duly recorded in said office in Book No. 2 of Registration Statements on page GR-262-C.

~~Certificate to be completed by x-x-x-x-x-x-x-x-x-x-19xx-x-x and the x-x to be completed by applicant x-x-x-x-x-x-x-x-x-x-