


GR 2892
GR 2893
GR 2894

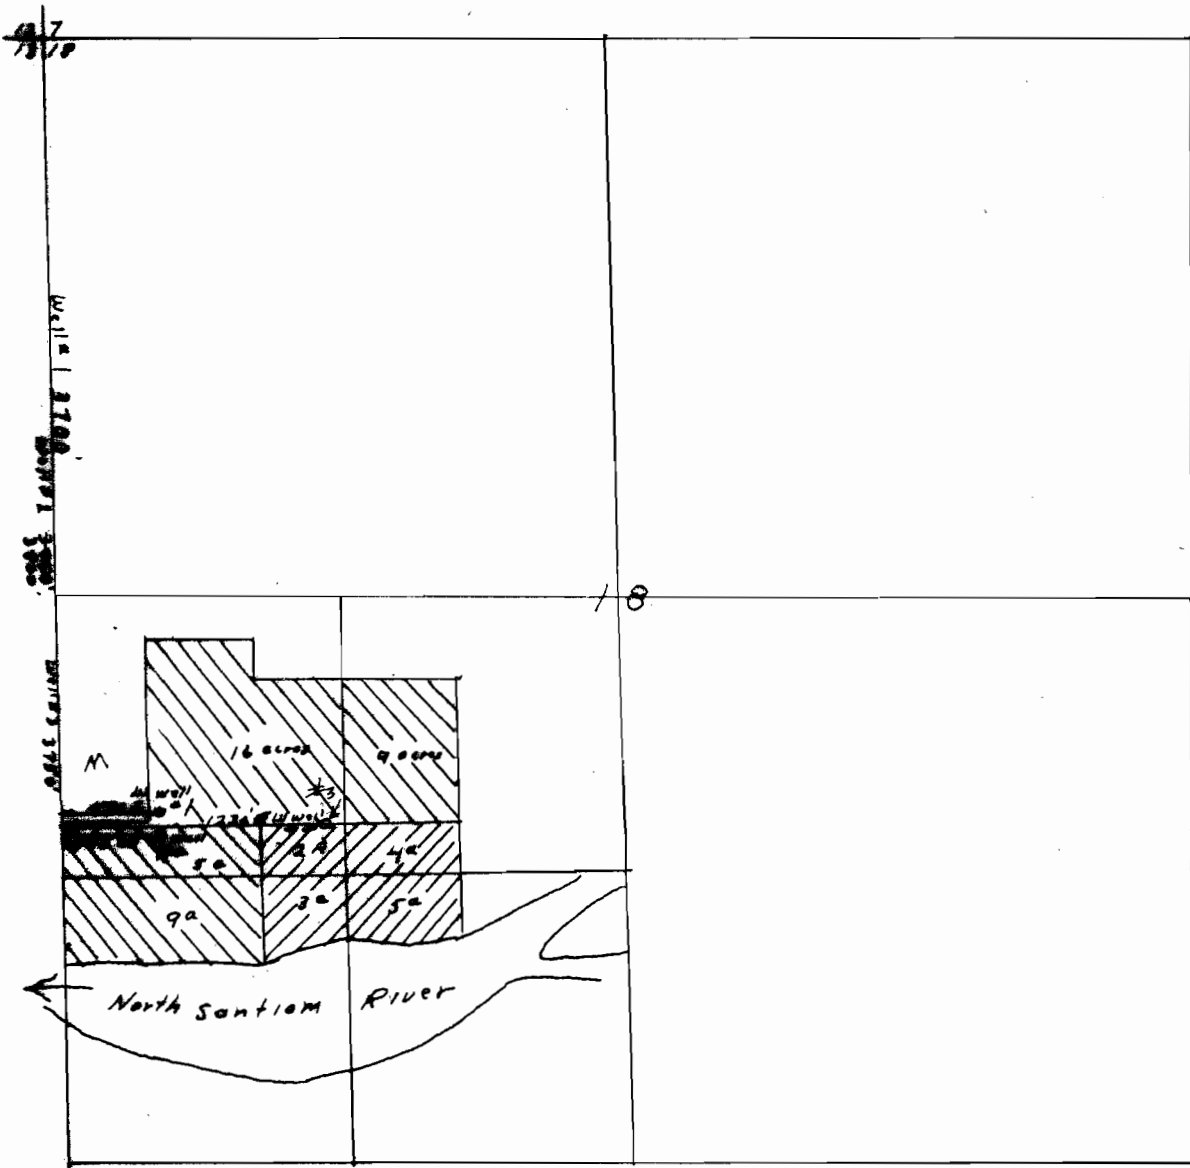

Herman Kieper
Township 10 South Range 2 West Sec. 18
Scale 1" = 660'

Wallace Dawson
Soil Conservation Service
Stayton Ore.
7-12-58