


Township 14S Range 5W W.M.
North

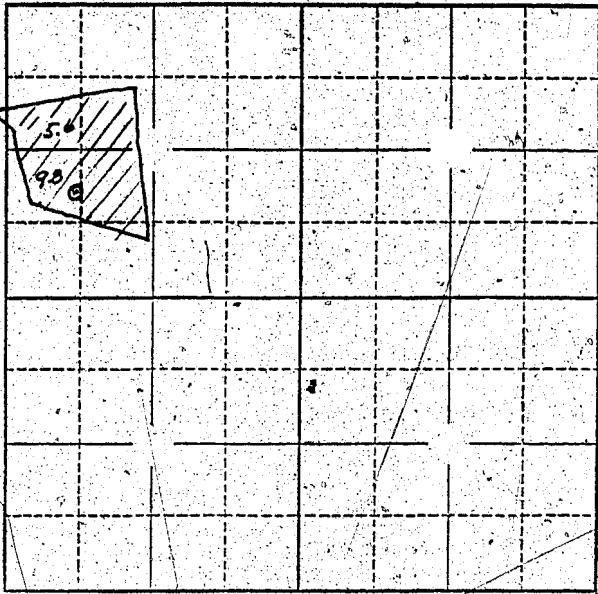

Locate well and acreage of irrigated land on plat.
Scale: $\frac{3}{4}$ " = 1 Mile

STATE OF OREGON

County of Benton } ss.

I, Freeman Edwin Graville, being first duly sworn, do hereby certify that I have read the foregoing Registration Statement and that all of the items therein contained are true to the best of my knowledge and belief.

Freeman Edwin Graville
(Signature of Registrant)

Subscribed and sworn to before me this 21st day of October, 1955

My commission expires December 11, 1955

D. Turner
(Notary Public)
Notary Public for Oregon

(SEAL)

CERTIFICATE OF REGISTRATION

STATE OF OREGON

County of Marion } ss.

This is to certify that the foregoing Registration Statement was received in the office of the State Engineer on the 24th day of October, 1955, at 8:00 o'clock A. M. and has been duly recorded in said office in Book No. 1 of Registration Statements on page 25

Construction shall be completed by _____, 19____, and the water ^{is} completely applied ^{is} beneficial use by _____, 19____.

Witness my hand this 24th day of February, 1956

Lewis A. Stanley
(State Engineer)

By _____
(Deputy)

GR-25 C