


North

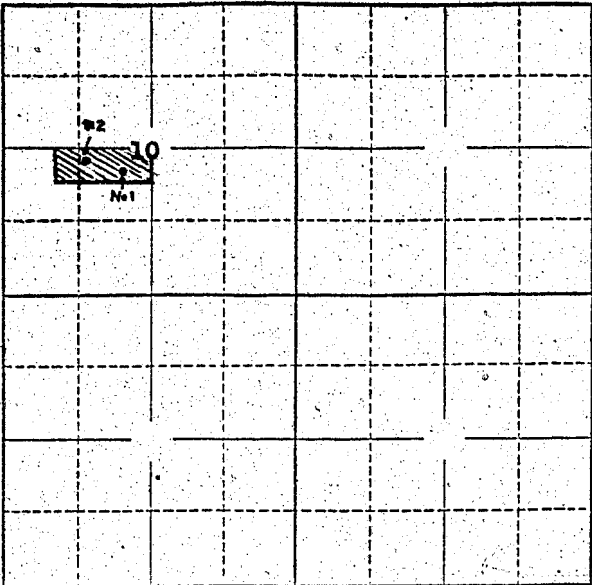

See Map in folder for accurate location

Locate well and acreage of irrigated land on plat.
Scale: 2" = 1 Mile

STATE OF OREGON

County of LANE } ss.

I, HERBERT C. NEAVE & Margaret E. Neave, being first duly sworn, do hereby certify that I have read the foregoing Registration Statement and that all of the items therein contained are true to the best of my knowledge and belief.

Margaret E. Neave Herbert C. Neave
(Signature of Registrant)

Subscribed and sworn to before me this 11th day of January, 1957.

My commission expires April 11, 1960
Felma Steubert
(Notary Public)

(SEAL)

SEE PAGE GR-298 G FOR
CERTIFICATE OF REGISTRATION

STATE OF OREGON

County of Marion } ss.

~~This is to certify that the foregoing Registration Statement was received in the office of the State Engineer on the x-x-x-x day of x-x-x-x-x-x-x-x, 19-x-x at x-x-x-x-x-x-x-x and has been duly recorded in said office in Book No. x-x-x-x-x-x of Registration Statements on page x-x-x-x-x-x-x-x. Construction shall be completed by x-x-x-x-x-x-x-x, 19-x-x and the water completely applied to benefited land by x-x-x-x-x-x-x-x, 19-x-x.~~


Witness my hand this day of, 19.....

(State Engineer)

By
(Deputy)

GR-298 C

North

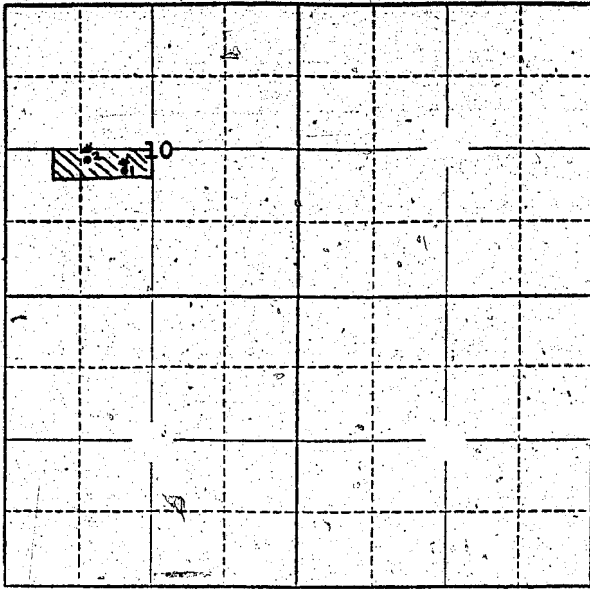

Locate well and acreage of irrigated land on plat.

Scale: 2" = 1 Mile

STATE OF OREGON

County of LANE } ss.

I, HERBERT C. NEAVE + Margaret E. Neave being first duly sworn, do hereby certify that I have read the foregoing Registration Statement and that all of the items therein contained are true to the best of my knowledge and belief.

Margaret E. Neave

Herbert C. Neave
(Signature of Registrant)

Subscribed and sworn to before me this 11th day of January, 1957.

My commission expires April 11, 1960

John Stuebath
(Notary Public)

(SEAL)

CERTIFICATE OF REGISTRATION

STATE OF OREGON

County of Marion } ss.

This is to certify that the foregoing Registration Statement was received in the office of the State Engineer on the 11th day of January, 1957, at 1 o'clock P. A.M. and has been duly recorded in said office in Book No. 2 of Registration Statements on page GR-298 G.

~~Construction shall be completed by x-x-x-x-x-x-x-x-x-x-x-x-1957 and the water completely applied to beneficial use by x-x-x-x-x-x-x-x-x-x-x-x-19~~

Witness my hand this 25th day of February, 1957.

Lewis A. Stanley
(State Engineer)

By _____ (Deputy)