


Township 3 S Range 1 E, W.M.

North

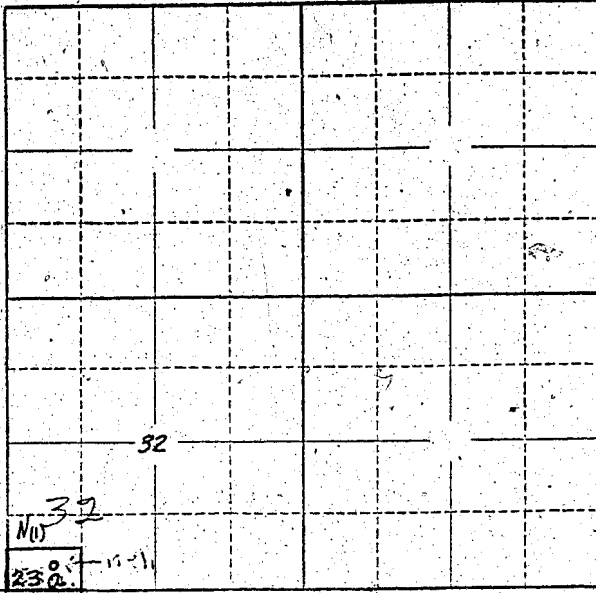

6 5 Locate well and acreage of irrigated land on plat.
Scale: 2" = 1 Mile

STATE OF OREGON
County of Clatsop } ss.

I, W F Cushing, being first duly sworn, do hereby certify that I have read the foregoing Registration Statement and that all of the items therein contained are true to the best of my knowledge and belief.

W F Cushing
(Signature of Registrant)

Subscribed and sworn to before me this 9th day of November, 1956

My commission expires Jan 24 1960

[Signature]
(Notary Public)

(SEAL)

CERTIFICATE OF REGISTRATION

STATE OF OREGON }
County of Marion } ss.

This is to certify that the foregoing Registration Statement was received in the office of the State Engineer on the 9th day of November, 1956, at 8 o'clock A.M. and has been duly recorded in said office in Book No. 2 of Registration Statements on page GR-264-C

~~Construction of this dam is completed by xxxxxxxx and the water completely applied to xxxxxxxx~~

Witness my hand this 15th day of January, 1957

Leurs A. Stanley
(State Engineer)

By _____ (Deputy)